


# T.5S.R.3 W.W.M.

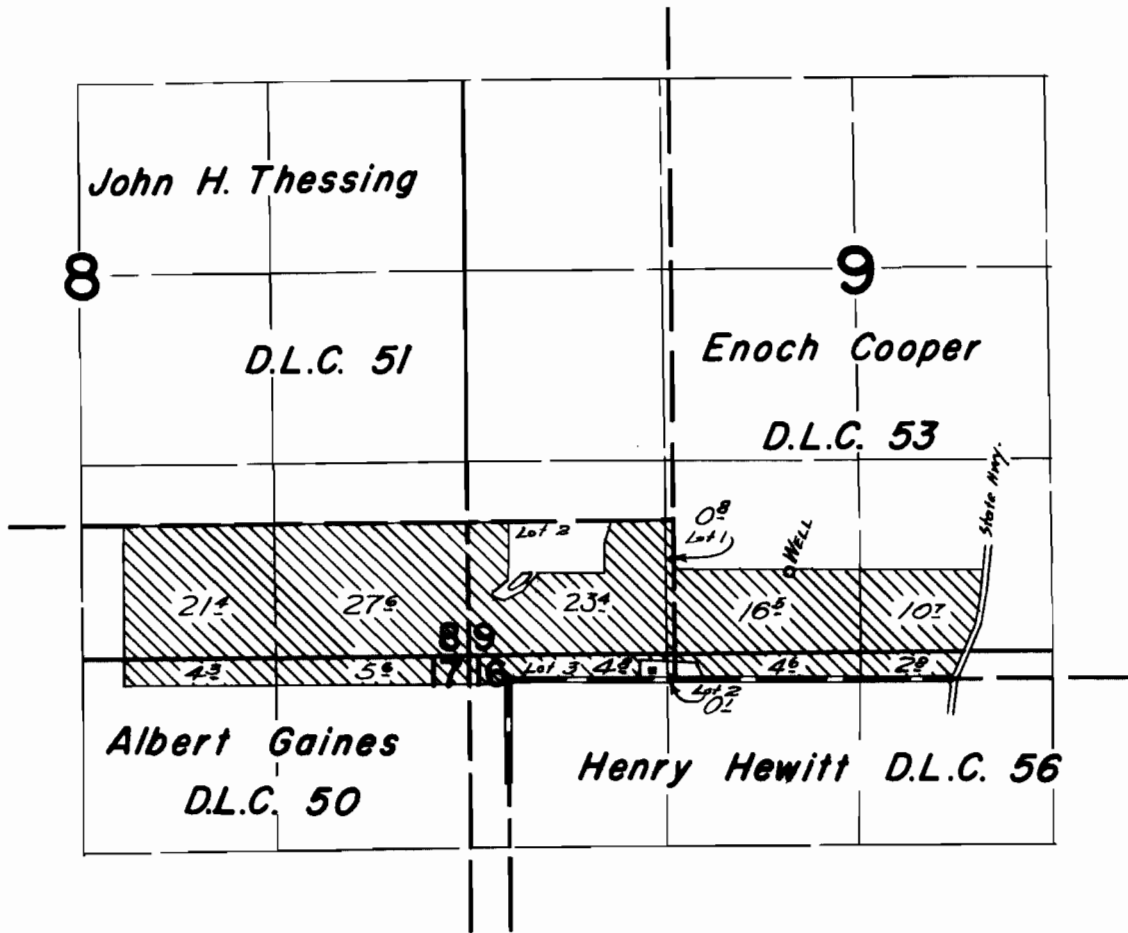

## FINAL PROOF SURVEY UNDER

Application No. G-1525... Permit No. G-1387...  
IN NAME OF

**NORMAN & JOYCE QUIGLEY**

Surveyed July 2, 1963, by *A. Johnson*