


RECEIVED

T.5S.R.3W.W.M.

NOV 30 1995

WATER RESOURCES DEPT.
SALEM, OREGON

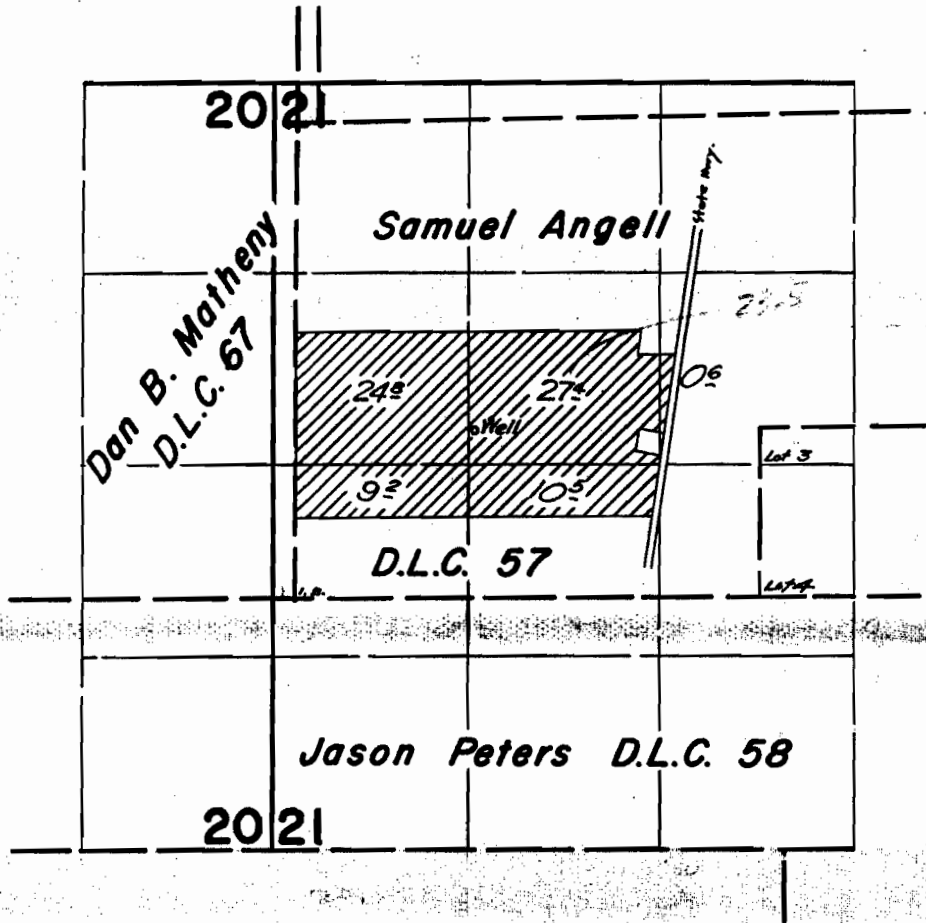

FINAL PROOF SURVEY
UNDER

Application No. G-1922. Permit No. G-1766.
IN NAME OF

F. EUGENE STOCKHOFF

Surveyed Sept. 5, 1903, by *[Signature]*