


T.4S.R.3W.W.M.

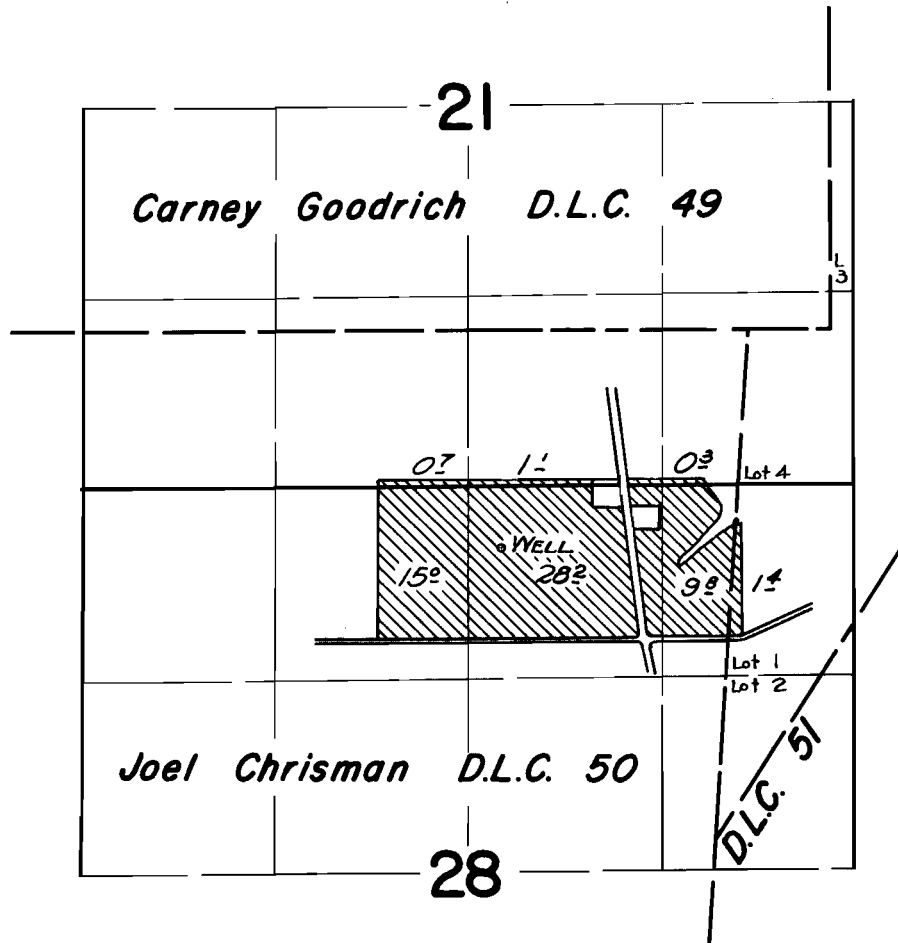

FINAL PROOF SURVEY
UNDER

Application No. G-2136 Permit No. G-1973
IN NAME OF

W. E. GRABENHORST

Surveyed Sept. 4 1963, by R. Jackson