


T.5S.R.3&4W.W.M.

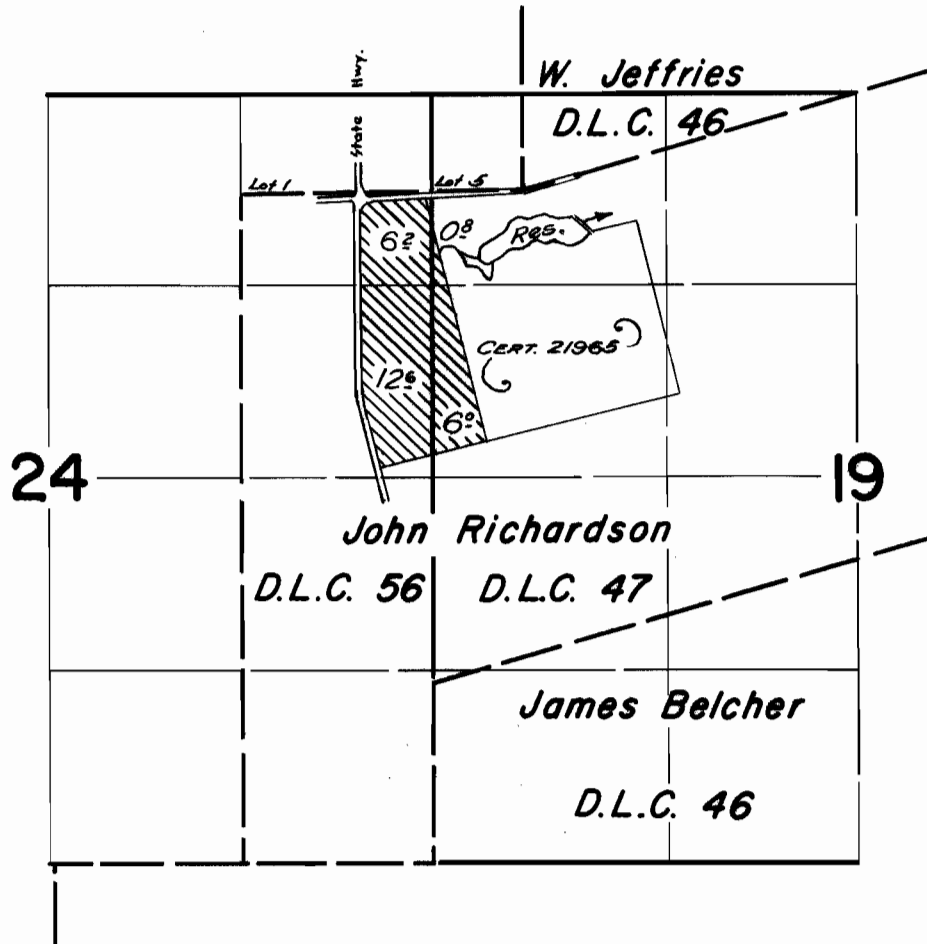

FINAL PROOF SURVEY
UNDER

Application No. 33546 Permit No. 26528
IN NAME OF

CARL WOOD

Surveyed July 1, 1963, by [Signature]