


# T.5S.R.3W.W.M.

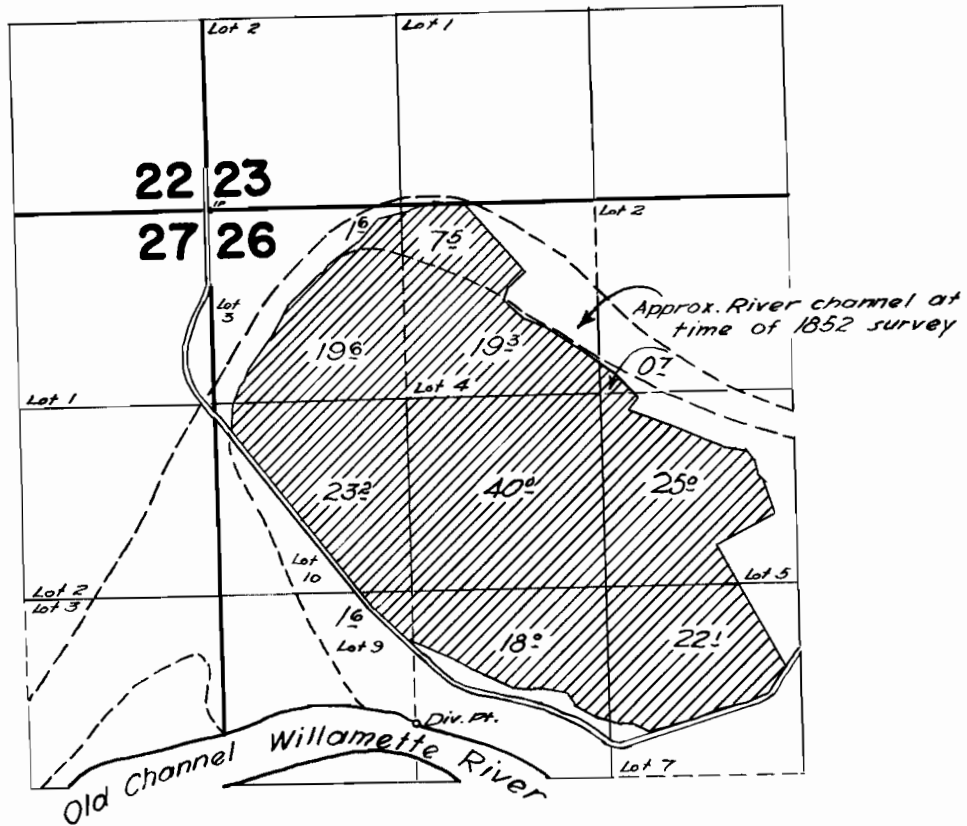

## FINAL PROOF SURVEY UNDER

Application No. 37185... Permit No. 27689...  
IN NAME OF

U. S. ALDERMAN

Surveyed July 2, 1963, by *R. Jackson*