


T. 11 S. R. 2 W. W. M.

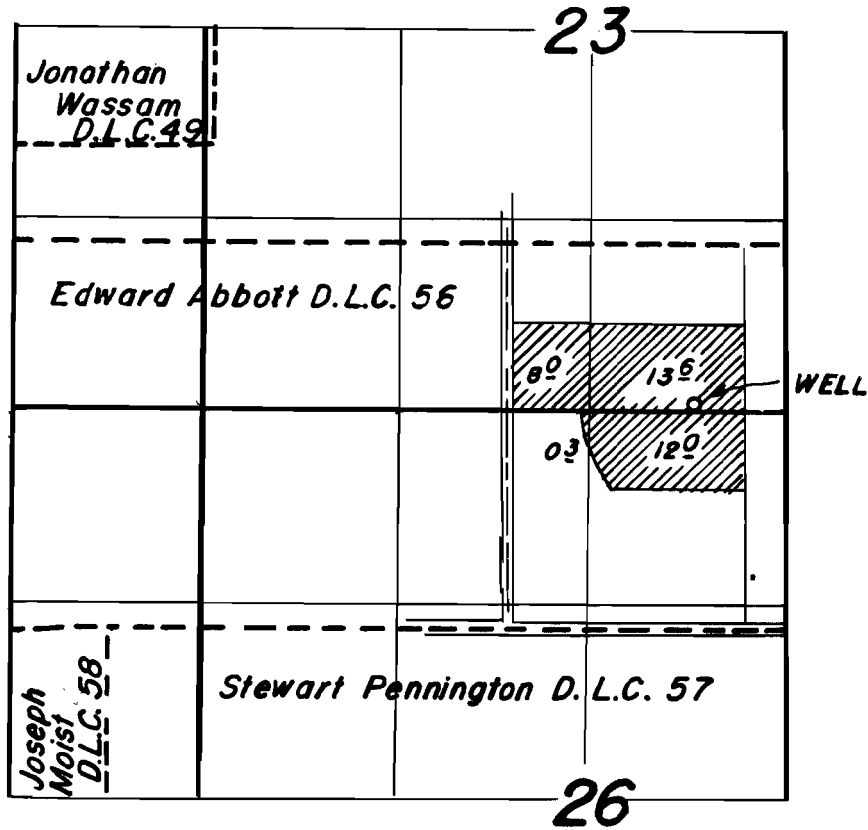

**FINAL PROOF SURVEY**  
UNDER

Application No. G-1299 Permit No. G-1165  
IN NAME OF

Surveyed Mar. 18 1963, by Floyd L. Siegmund