


70

T. 2N. R. 10E. W.M.

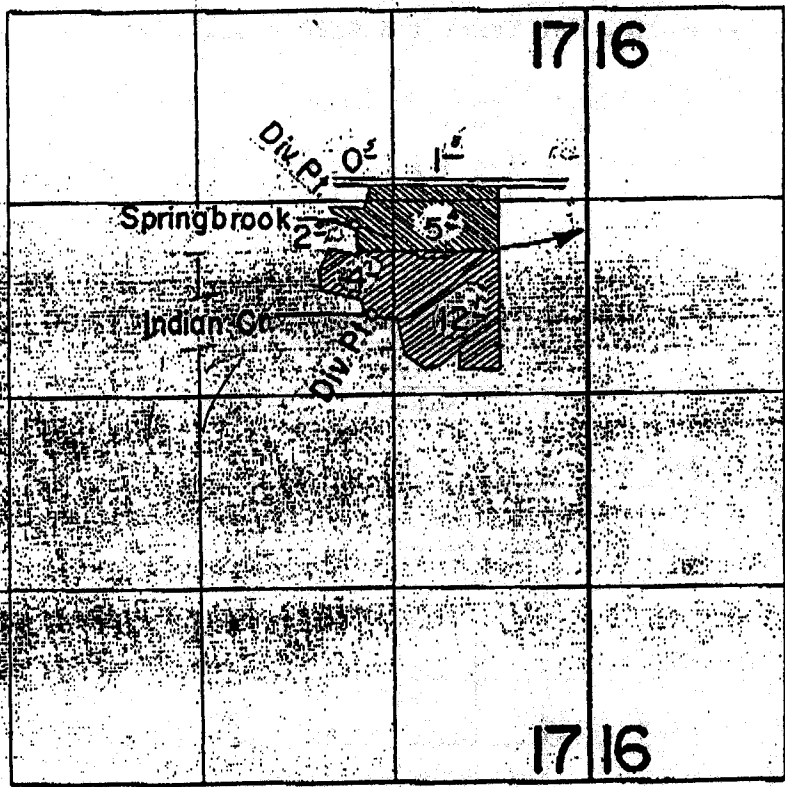

FINAL PROOF SURVEY UNDER

Application Transfer No. W-76 No.
IN NAME OF

JOHNNY Y. WAKAMATSU

Surveyed April 5, 1963, by *Larry W. Gebauer*