


SURVEYOR'S CERTIFICATE

I, W. E. Anderson of Tillamook Ore. do hereby certify that this map was made from notes taken during an actual survey made by me in November 1958, and that it correctly represents the works herein

W. E. Anderson

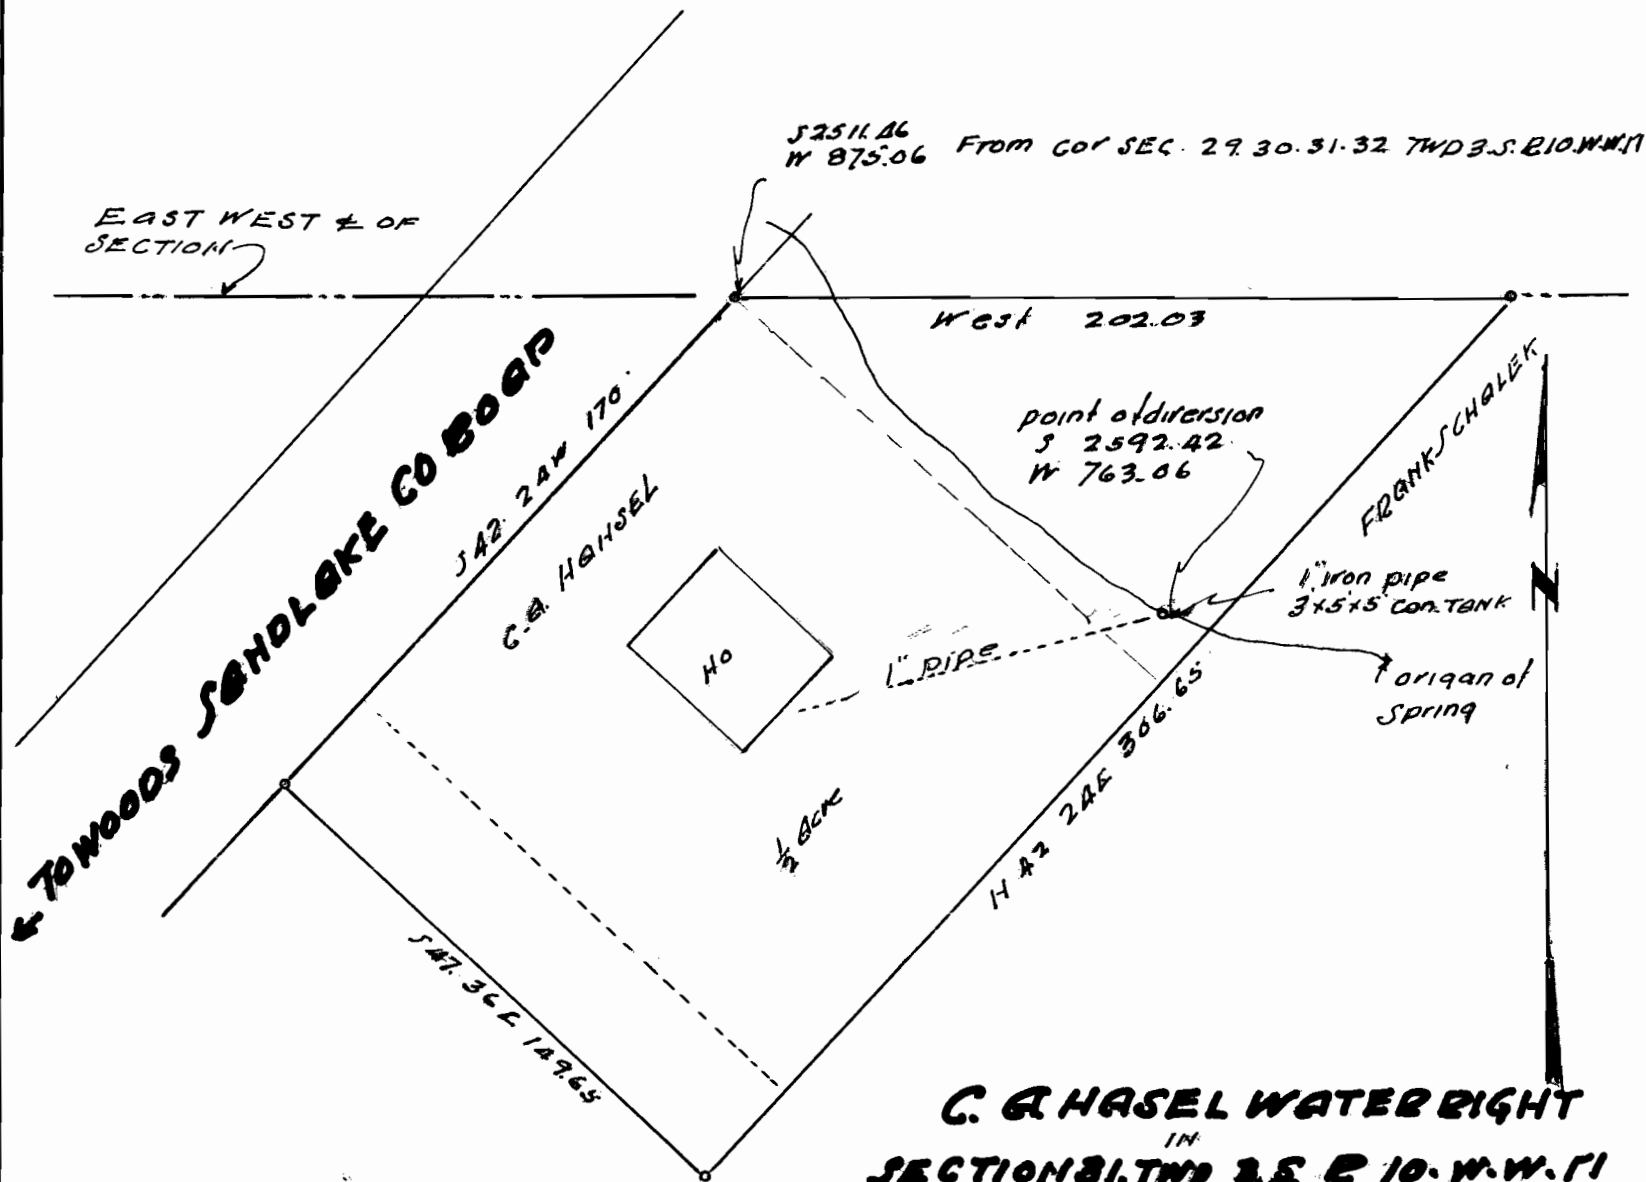

C. A. HASEL WATER RIGHT
IN
TILLAMOOK COUNTY ORE
Scale 1"=50
W. E. Anderson Co Surv.

Application No. 32740
Permit No. 25845

W. E. Anderson