


T. 2S. R. 2E. W.M.

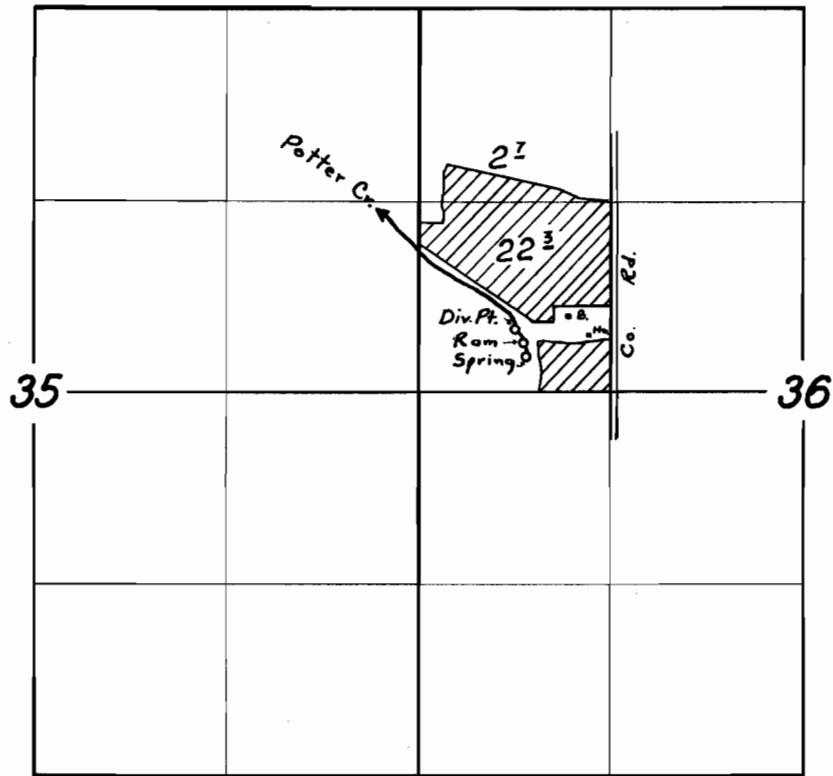

**FINAL PROOF SURVEY**  
UNDER

Application No. 25432 Permit No. 20005  
IN NAME OF

HUGHLON E. FAULK

Surveyed 19 June 1956, by M. Bish

DFK-1D-43

*Emt*