


# T.12S.R.38E.W.M.

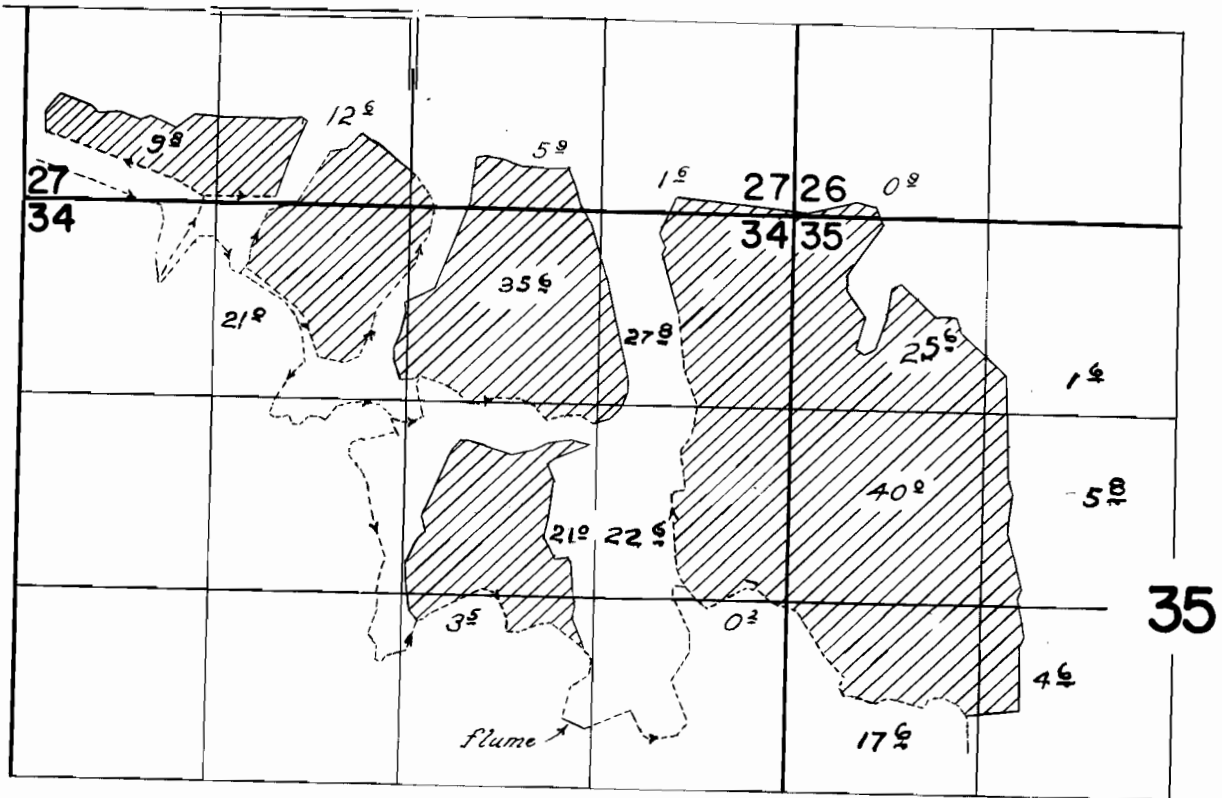

## FINAL PROOF SURVEY UNDER

Application No. 8247 Permit No. 5382  
IN NAME OF

*Camp Creek Water Company*

Surveyed July 10 & 11, 1962, by Thomas R. Lauer.