


T.9S.R.44E.W.M.

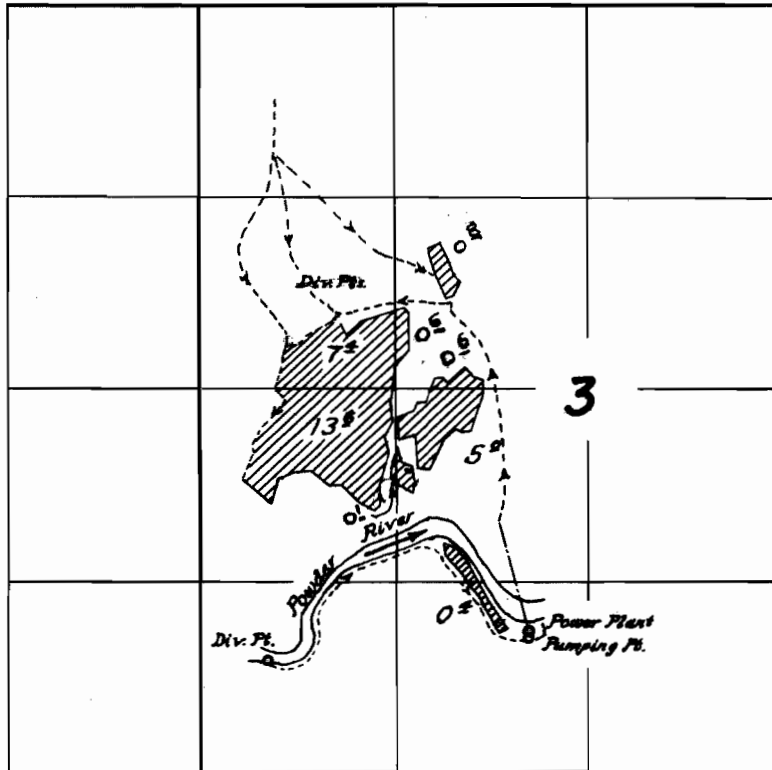


FINAL PROOF SURVEY UNDER

Application No. ³⁰¹³⁷ ~~33019~~ Permit No. ²³⁷⁸¹ ~~26107~~
IN NAME OF

Joe H. Hanby

Surveyed *August 21*, 19*62*, by *Thomas R. Lauer*

T.9S. R.44E.W.M.

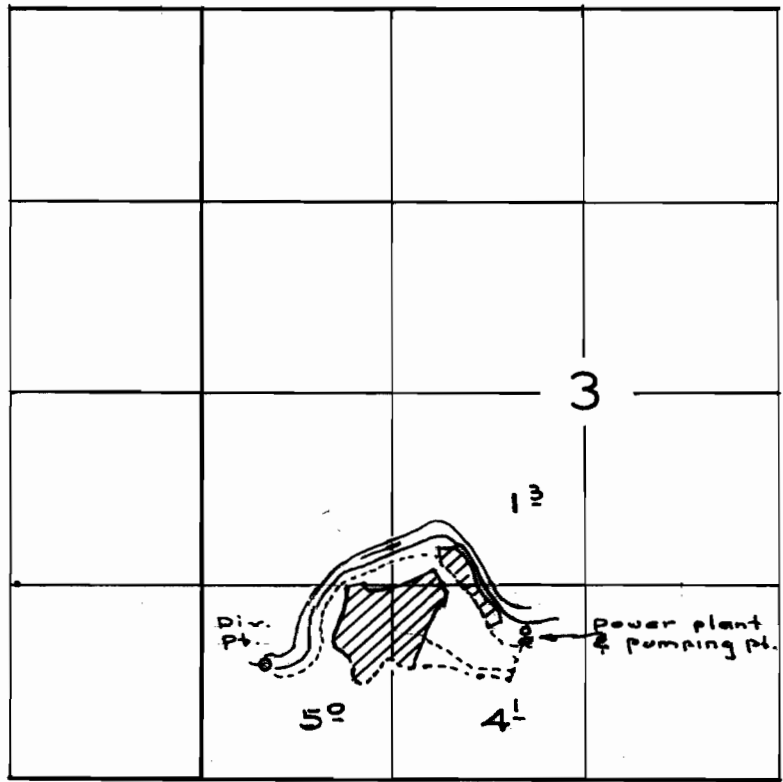

Note: This map shows only irrigated lands south of Powder R. Lands north are shown on previous survey.

FINAL PROOF SURVEY UNDER

Application No. 30137 Permit No. 23781
IN NAME OF

JOE H. HANBY

Surveyed April 23 1964 by D. B. Hall