


T.24 S. R. 12 W. W. M.

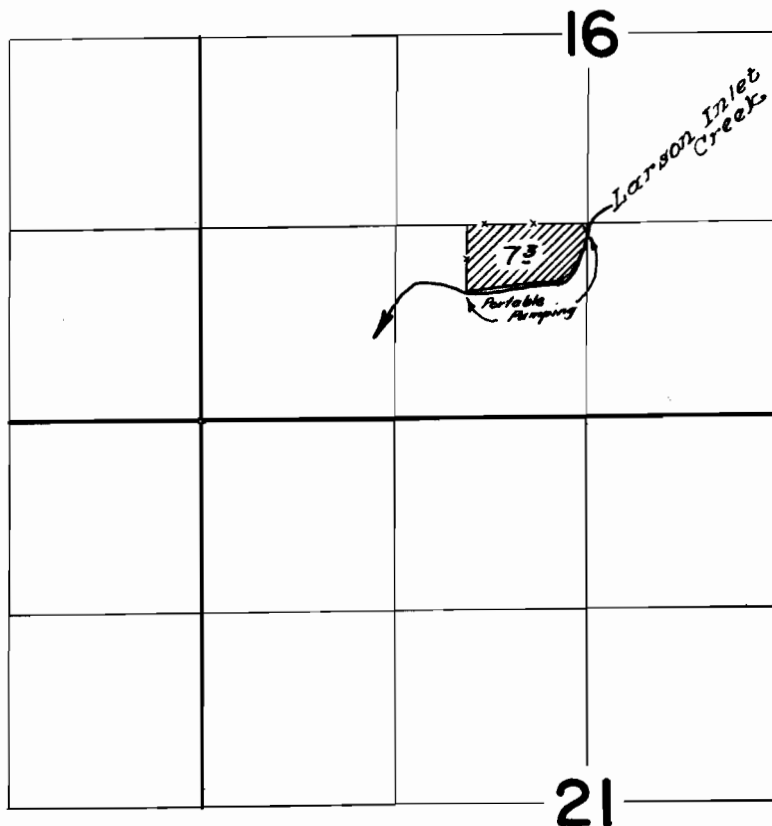

FINAL PROOF SURVEY UNDER

Application No. 32590... Permit No. 25720...
IN NAME OF

..... J. M. HANSON

Surveyed August 12, 1963, by

[Signature]