


T.24S.R.13W.W.M.

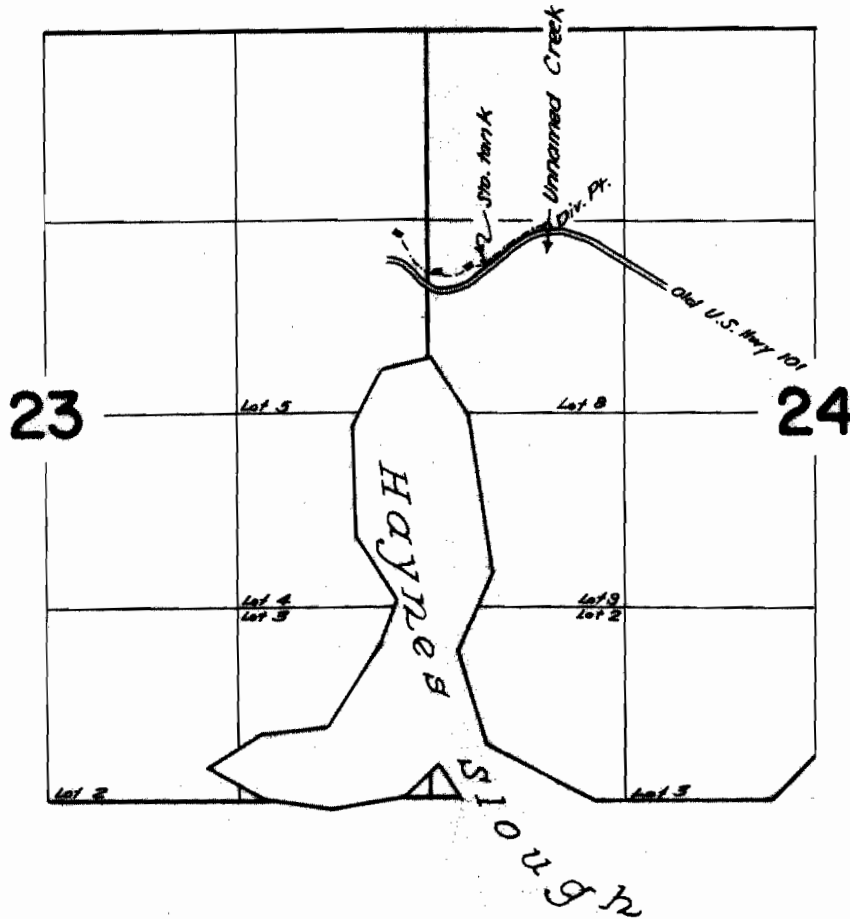

FINAL PROOF SURVEY
UNDER

Application No. 34053.. Permit No. 26846..
IN NAME OF
ROBERT E. EVANSON, H. W. WALTHER
& PAUL J. & BARBARA SCHALLER

Surveyed August 6, 1963, by *R. Jackson*