


# T.24S.R.3W.W.M.

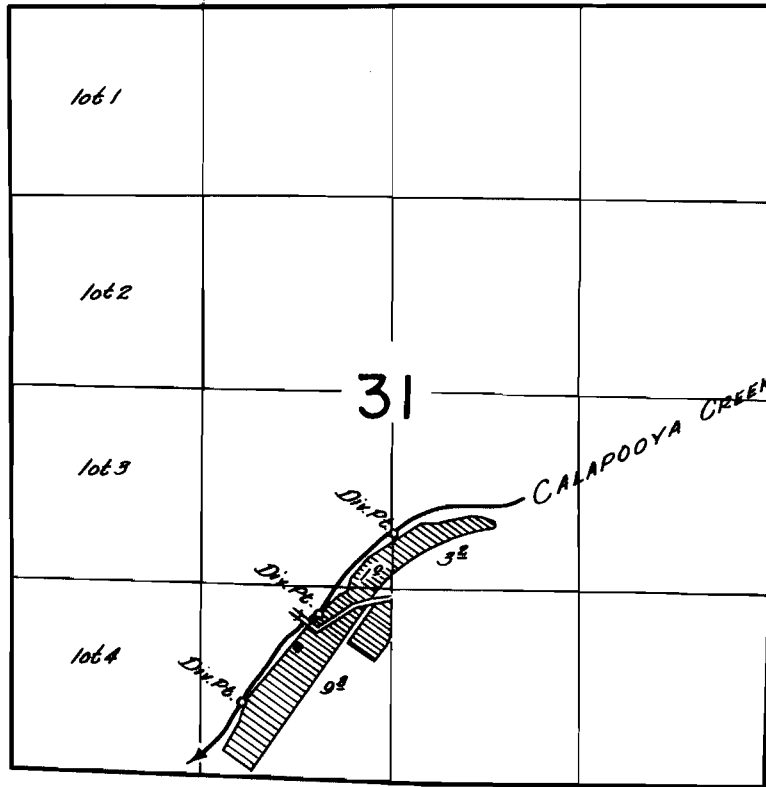

## FINAL PROOF SURVEY UNDER

Application No. 33453 Permit No. 26438  
IN NAME OF

T.M. Roper

Surveyed Sept. 19 1963, by G.O. Bartels