


T.22S.R.10W.W.M.

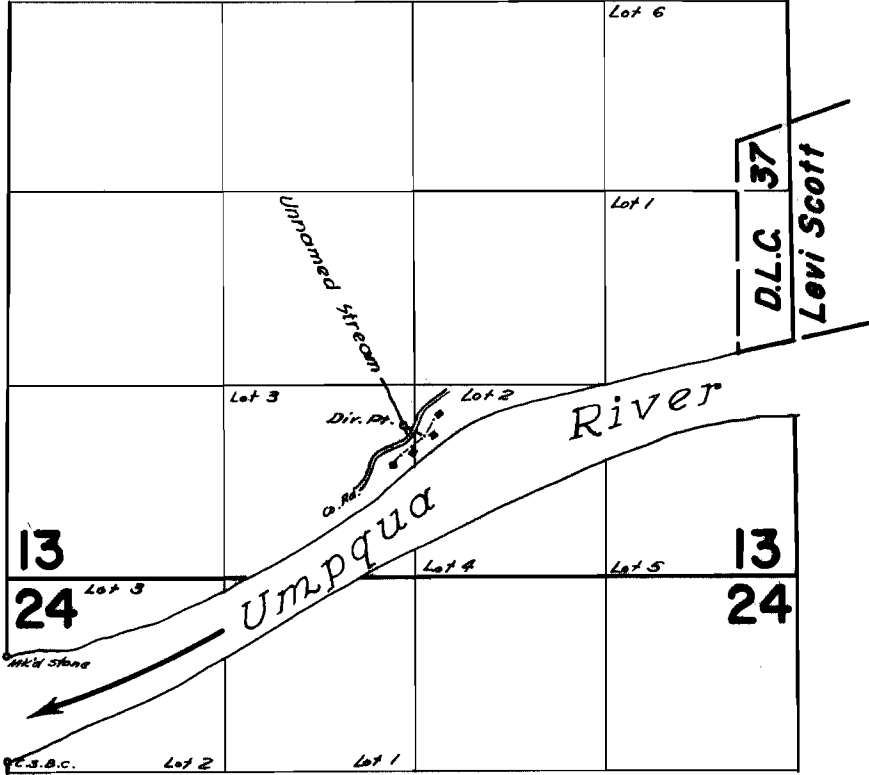

FINAL PROOF SURVEY
UNDER

Application No. 37933 Permit No. 28296
IN NAME OF

CLYDE H. SEETS

Surveyed August 7 1963, by R. H. Jackson