


T.24 S. R.30 E.W.M.

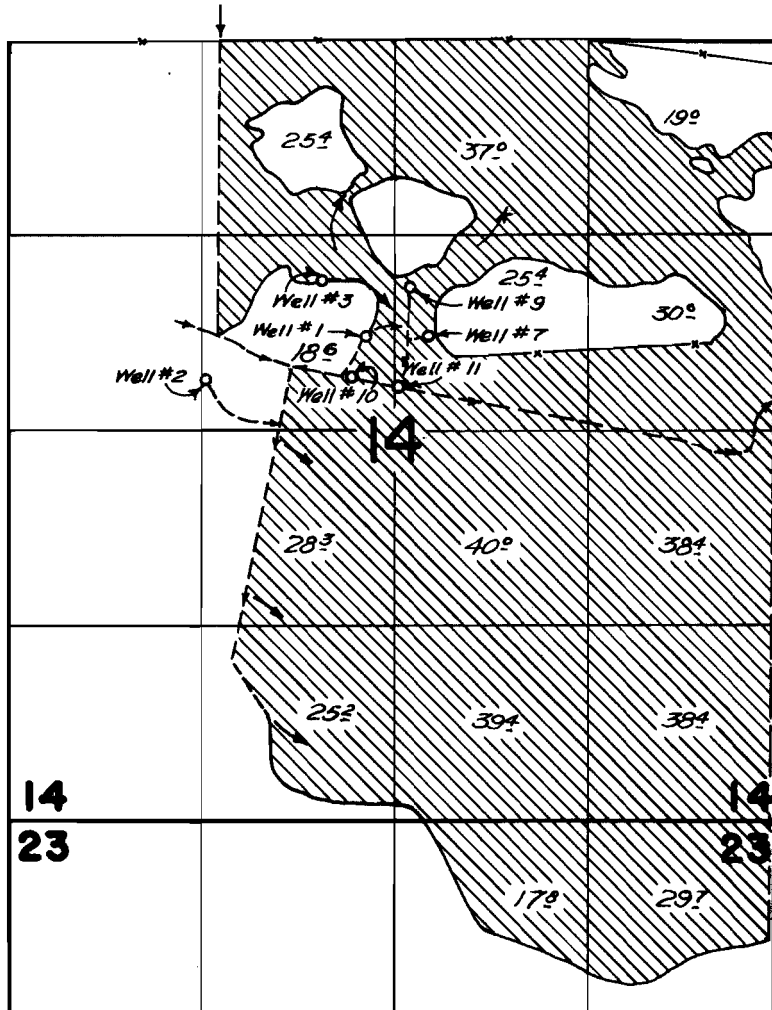

**FINAL PROOF SURVEY**  
UNDER

Application No. U-747 Permit No. U-667  
IN NAME OF

FRANK W. & ROSE SCHMIDT

Surveyed Oct. 18, 1960, by R. Johnson  
& Sept. 14, 1963,