


T.25&26S.R.34E.W.M.

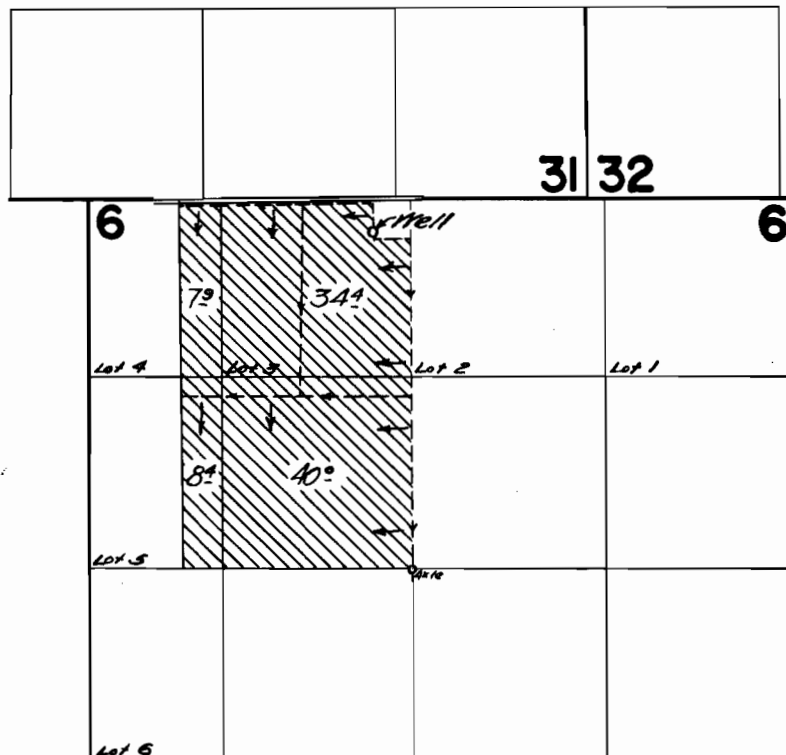

FINAL PROOF SURVEY
UNDER

Application No. G-317 Permit No. G-27
IN NAME OF

JOHN J. FECHT

Surveyed Sept 18 1963, by R. J. Jackson