


T.25S.R.34E.W.M.

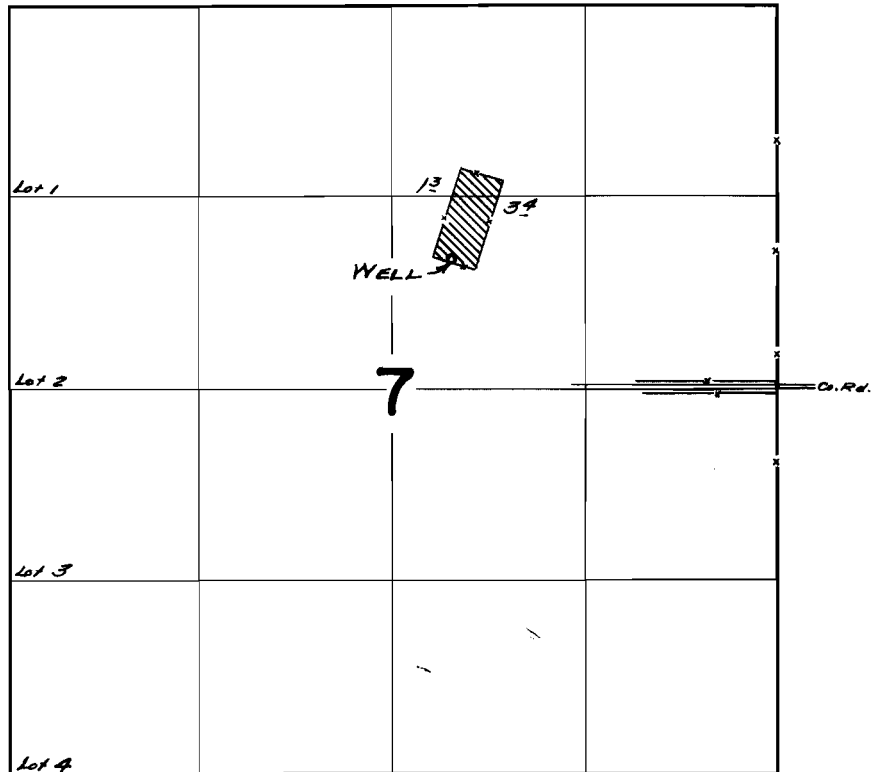

FINAL PROOF SURVEY UNDER

Application No. G-17.74. Permit No. G-1623.
IN NAME OF

CRANE UNION HIGH SCHOOL NO. 1

Surveyed Sept. 13, 1963, by *R. Johnson*