


T.38S. R.12E.W.M.



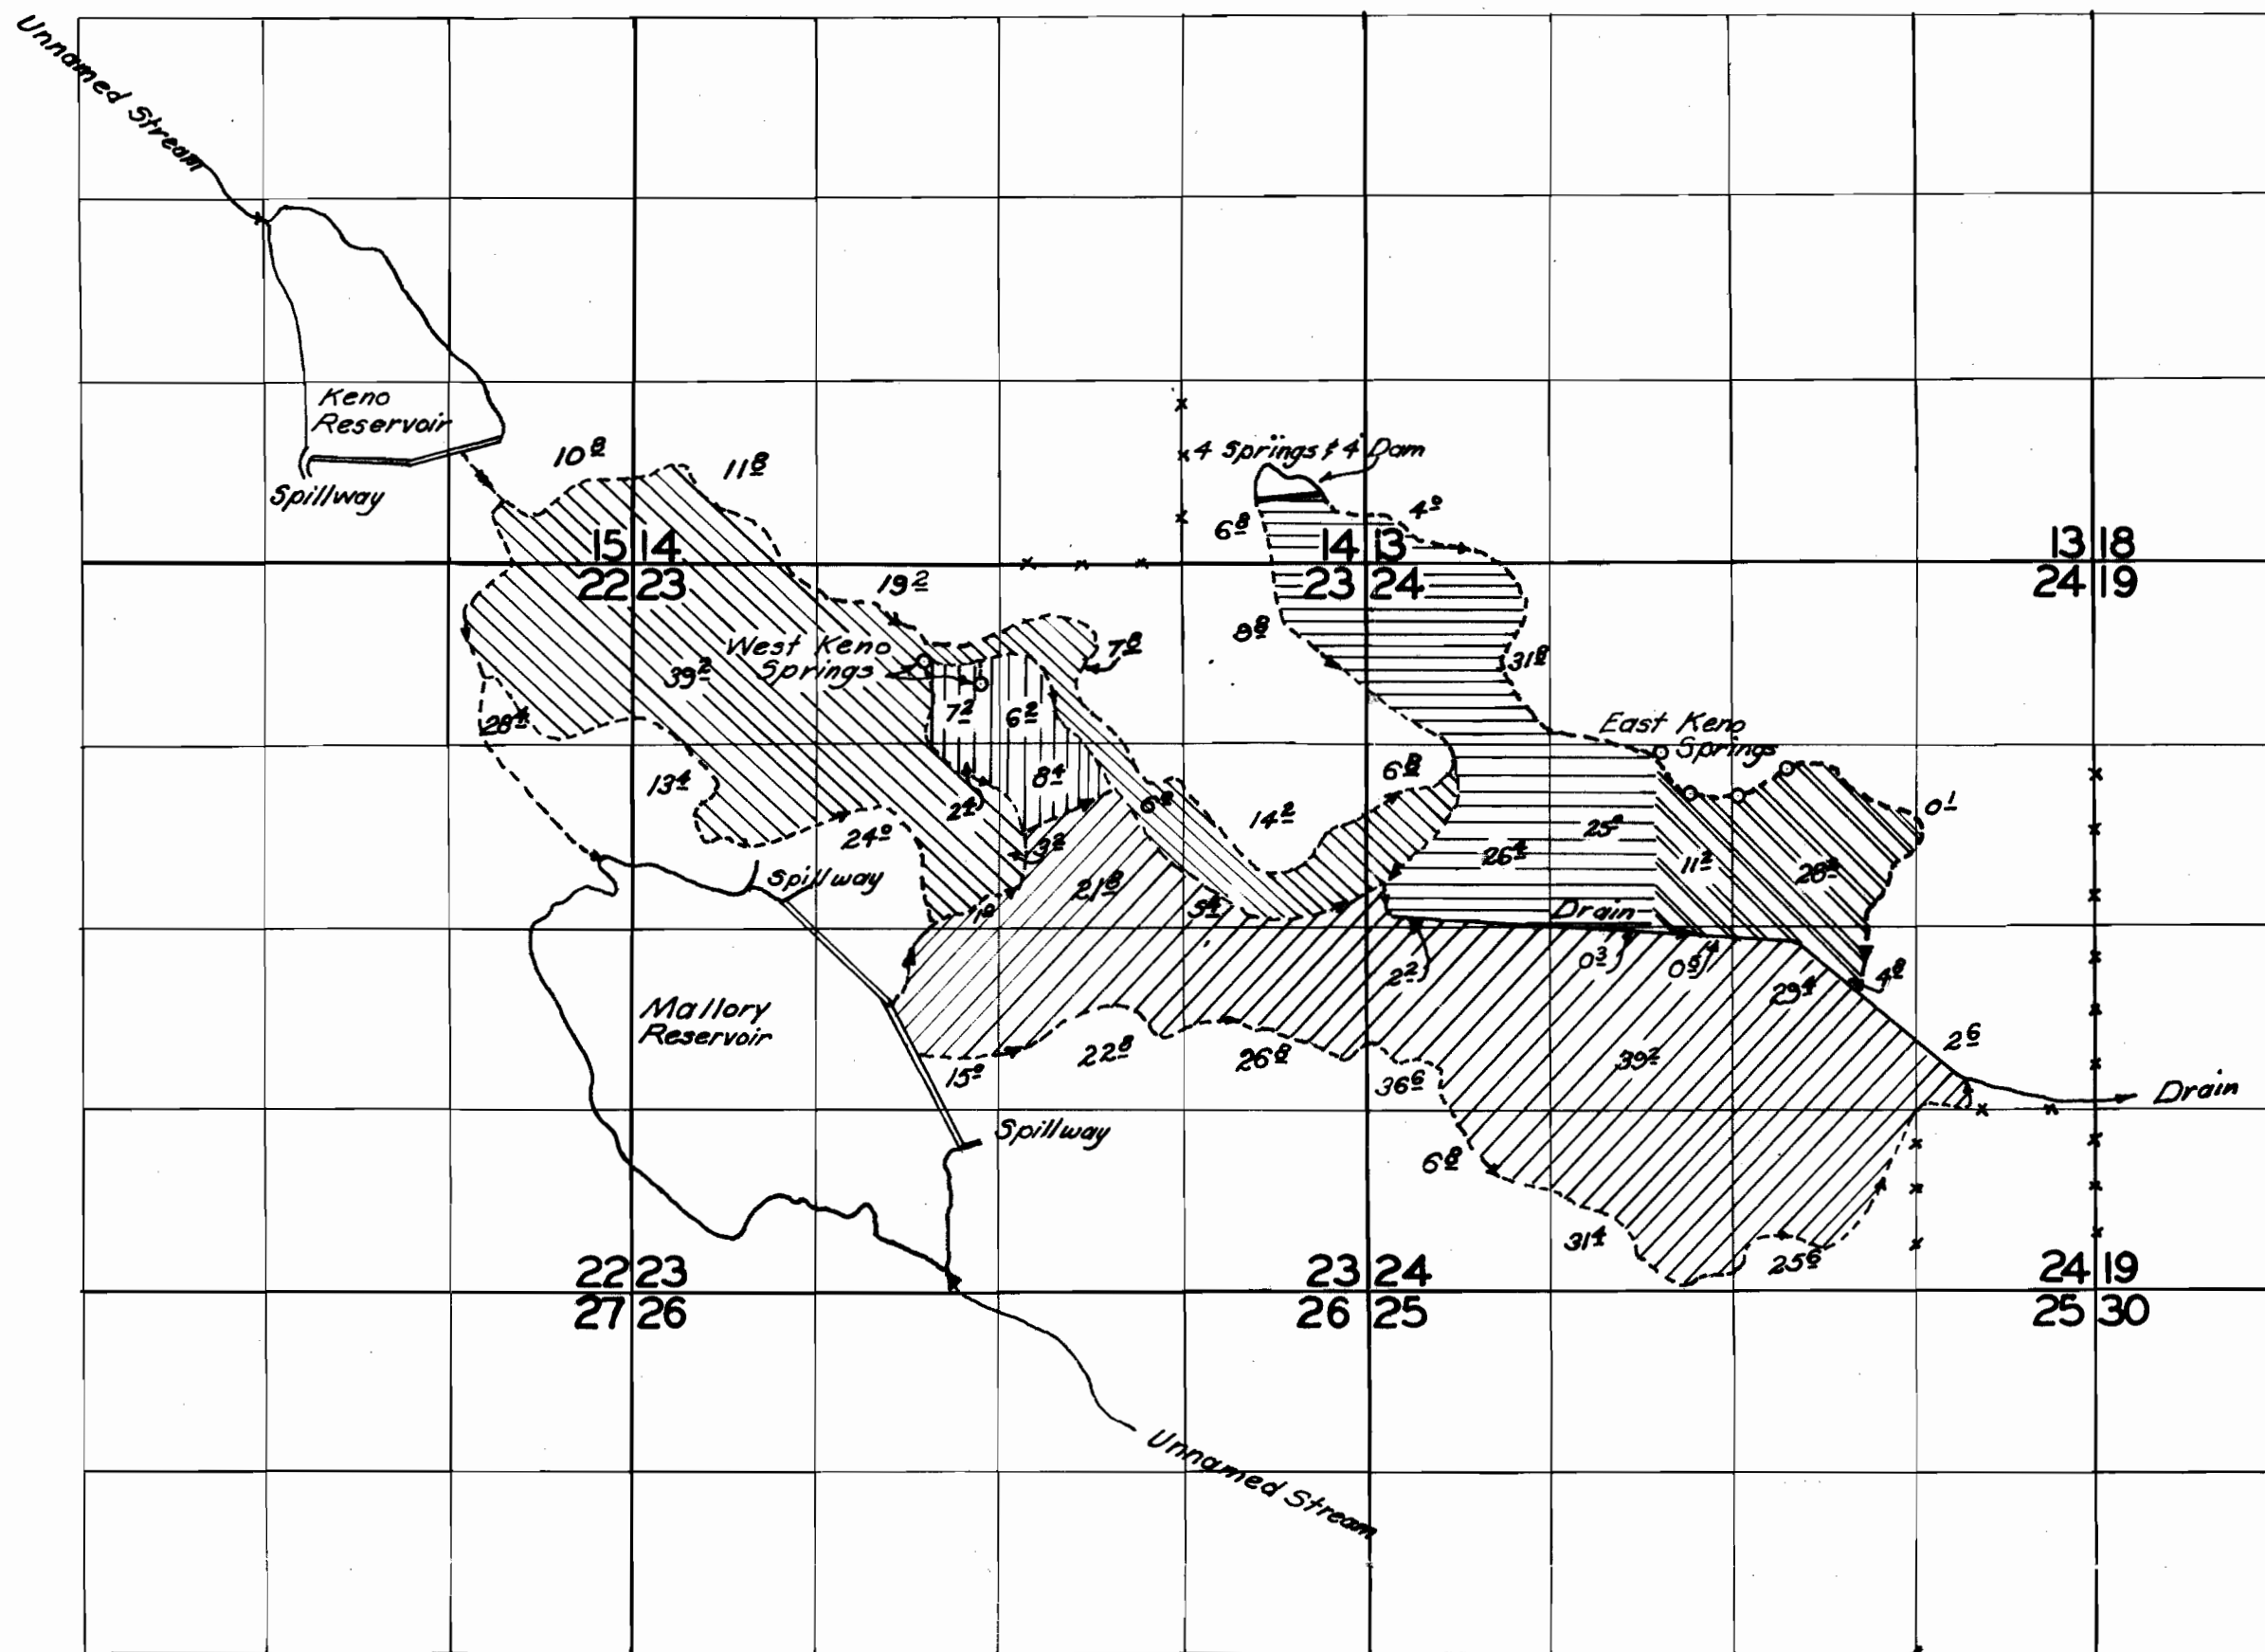


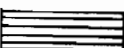
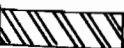
FINAL PROOF SURVEY
UNDER

Application No. *R-31693* Permit No. *R-2247*
31694 *26216*

IN NAME OF

H.M., Christine, & Gordon E. Mallery

Surveyed July 11, 1961 by *M. Bish*

-  Irrigated from Keno Reservoir
-  Irrigated from West Keno Springs
-  Irrigated from Mallery Reservoir
-  Irrigated from 4 unnamed Springs
-  Irrigated from East Keno Springs