


T.38S. R.12E.W.M.

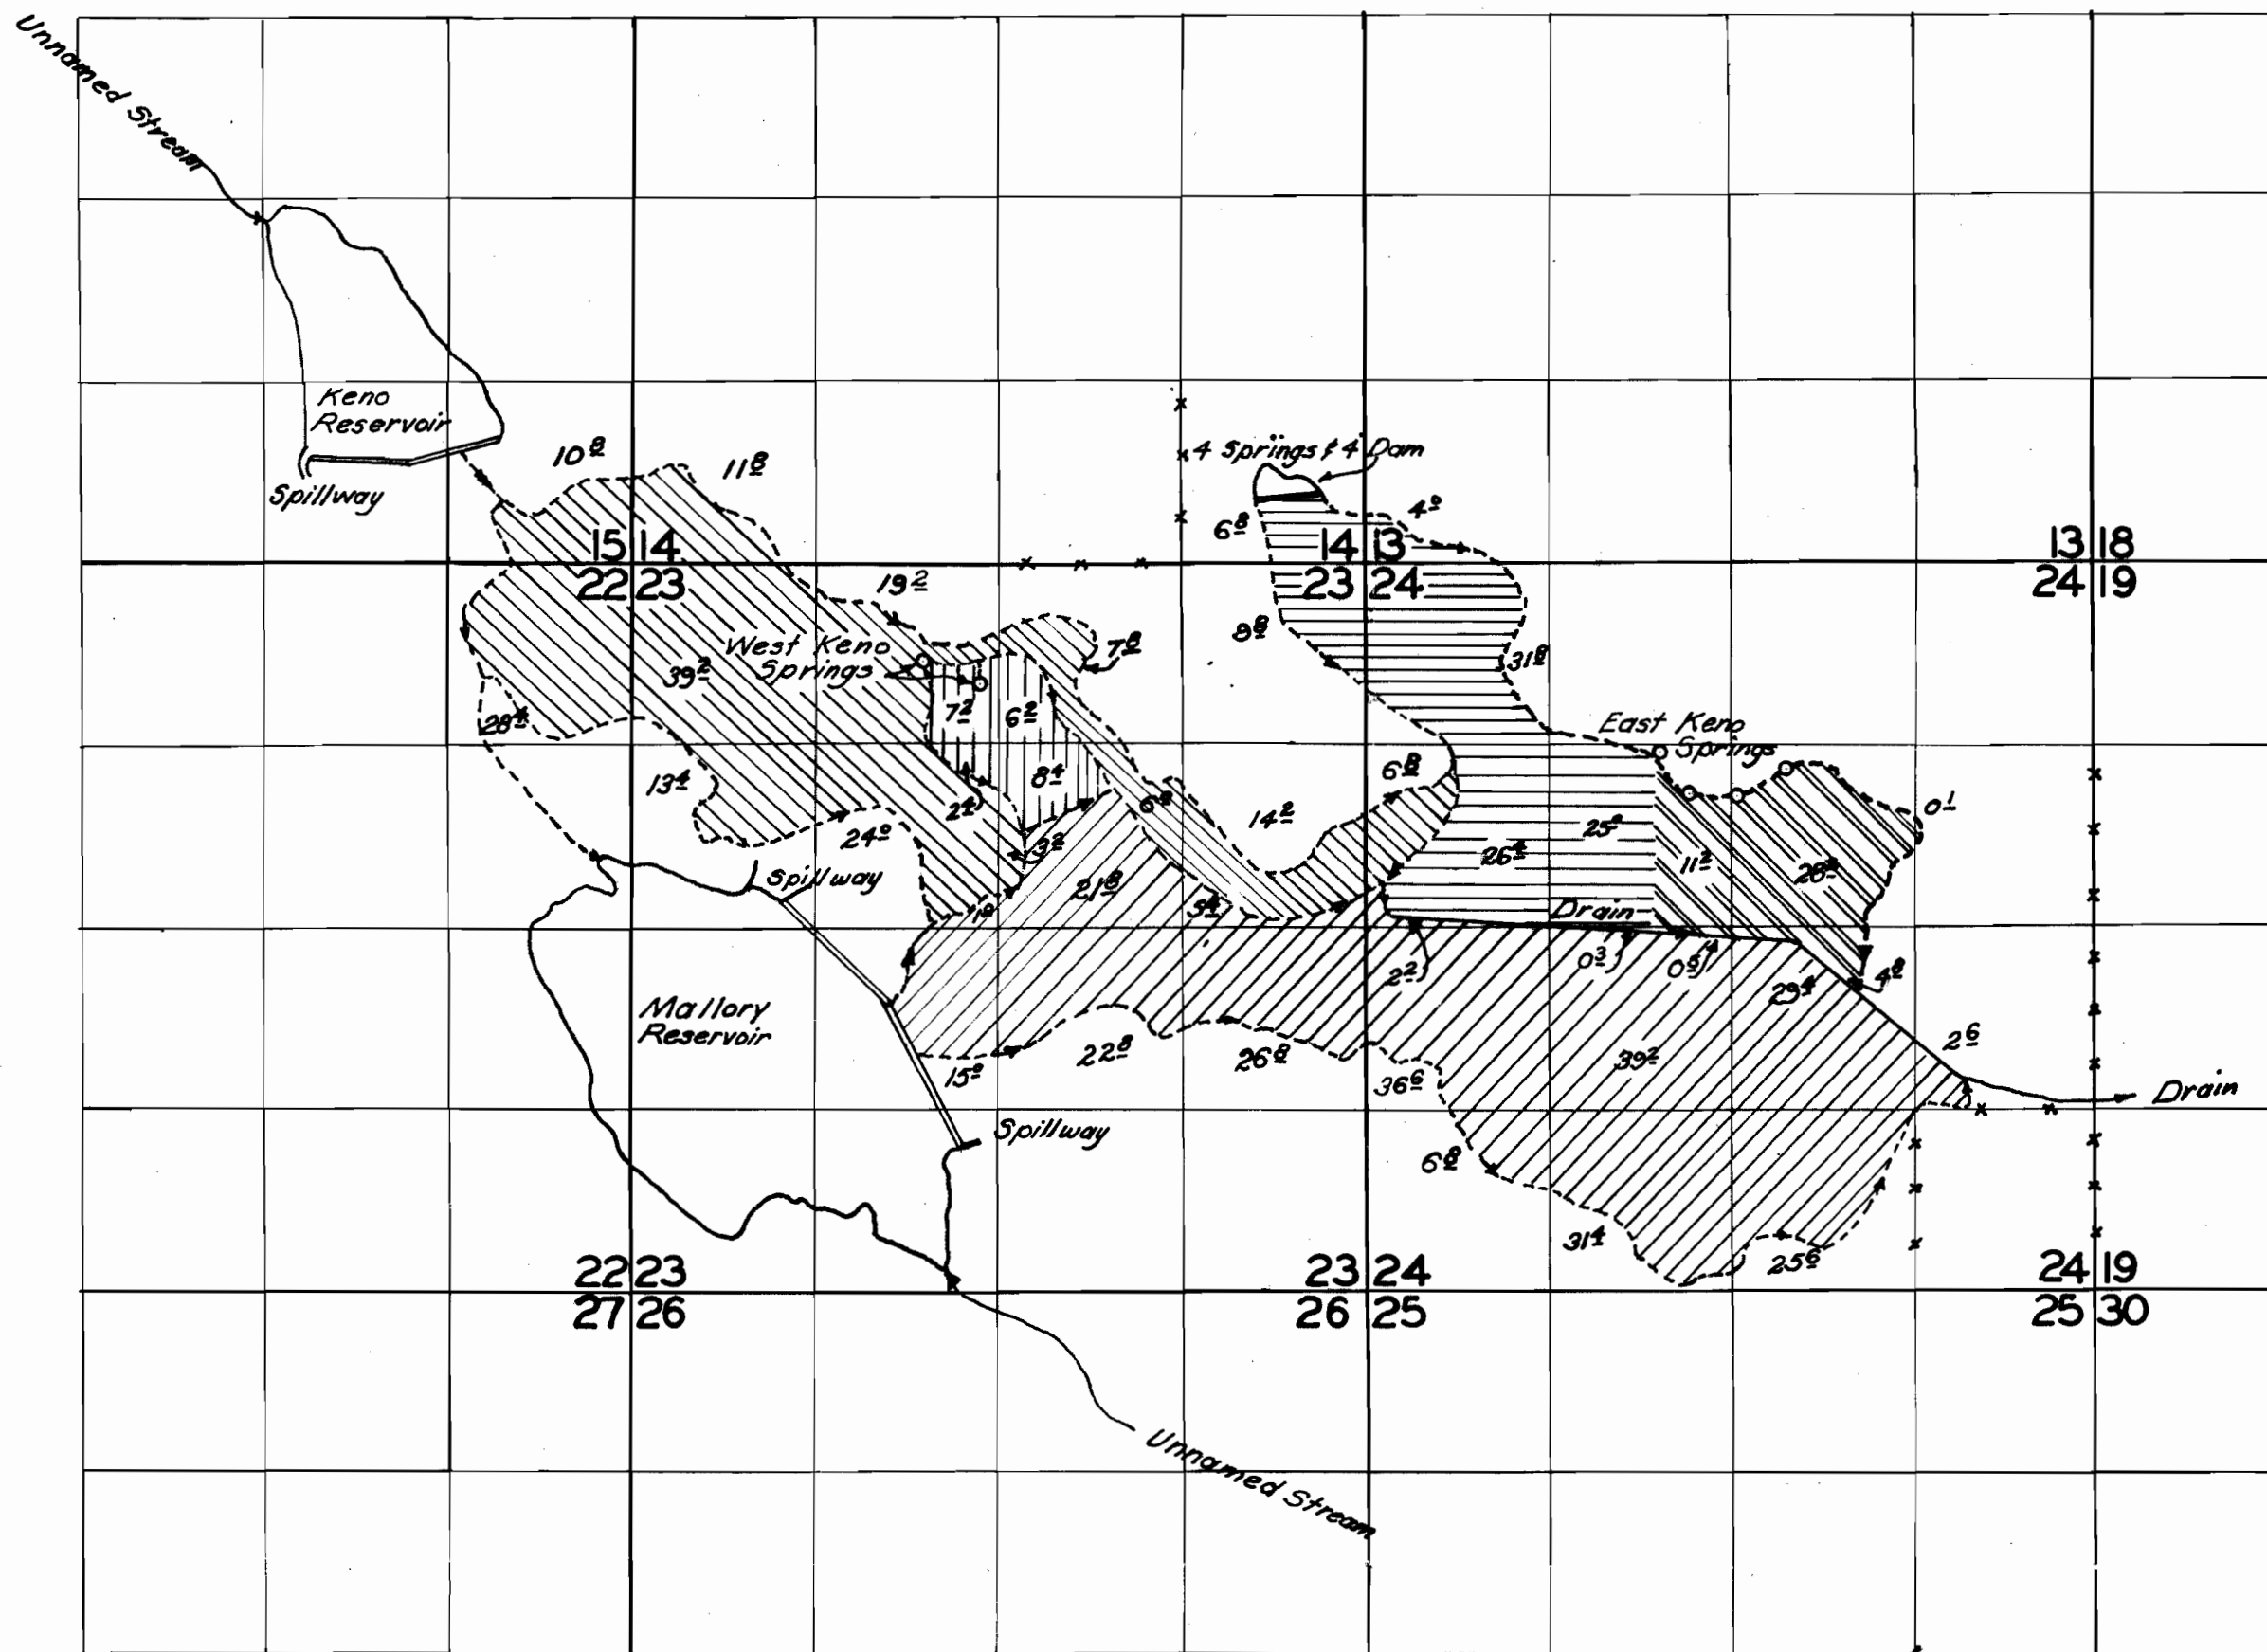

FINAL PROOF SURVEY  
UNDER

Application No. *R-31693* Permit No. *R-2247*  
*31694* *26216*

IN NAME OF

*H.M., Christine, & Gordon E. Mallery*

Surveyed July 11, 1961 by *M. Bish*

- Irrigated from Keno Reservoir
- Irrigated from West Keno Springs
- Irrigated from Mallery Reservoir
- Irrigated from 4 unnamed Springs
- Irrigated from East Keno Springs