


T.15 S. R. 4 W. W.M.

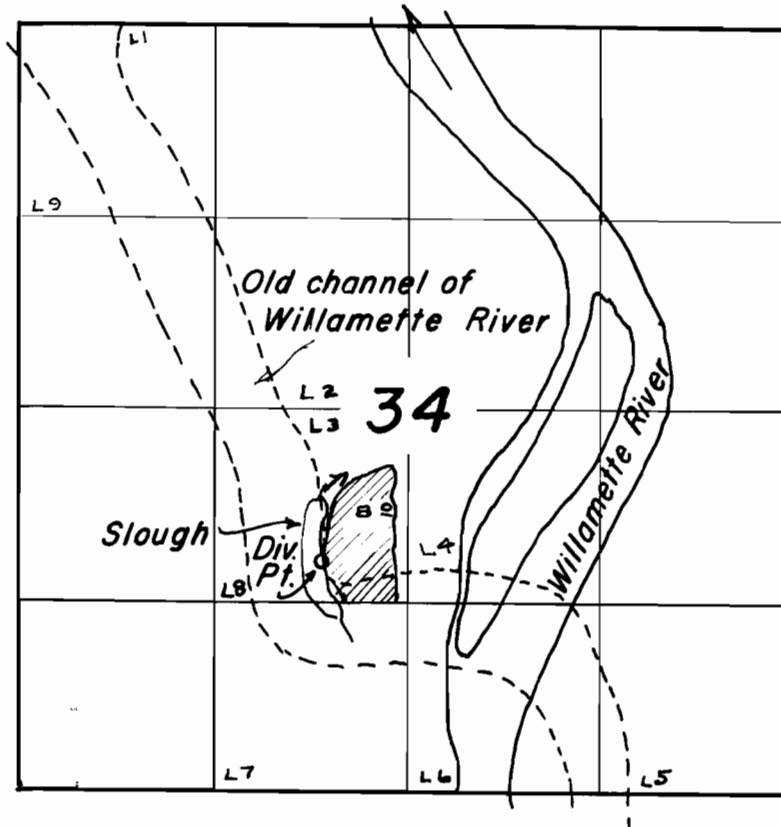

FINAL PROOF SURVEY
UNDER

Application No. 34927 Permit No. 27401
IN NAME OF

Merle Hentze

Surveyed June 19 1963, by T. Lauer