


# T.6S.R.2W.W.M.

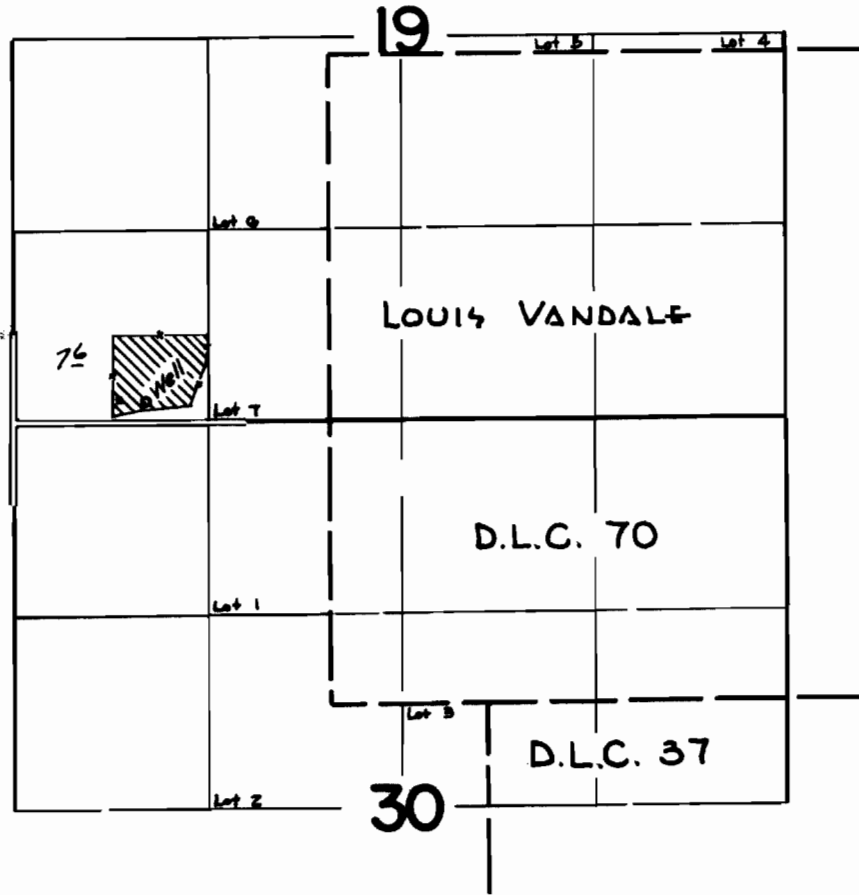

## FINAL PROOF SURVEY UNDER

Application No. G-1531. Permit No. G-1406  
IN NAME OF

PETER JOHN MURRAY

Surveyed April 26 1963, by T. LAUER.....

*rt*