


T. 1N. R. 4E W.M.

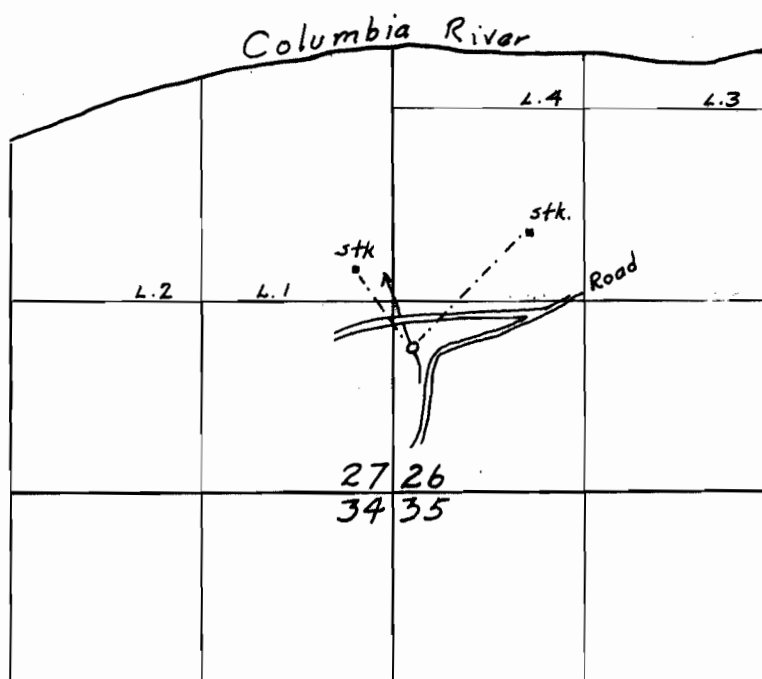

FINAL PROOF SURVEY UNDER

Application No. 37880 Permit No. 28231.....
IN NAME OF

Dr. F.W. Hill & J.H. Lamb & Robert A. Lamb.....

Surveyed July 26, 1964, by T. Louer.....