


T. 8S. R4W.W.M.

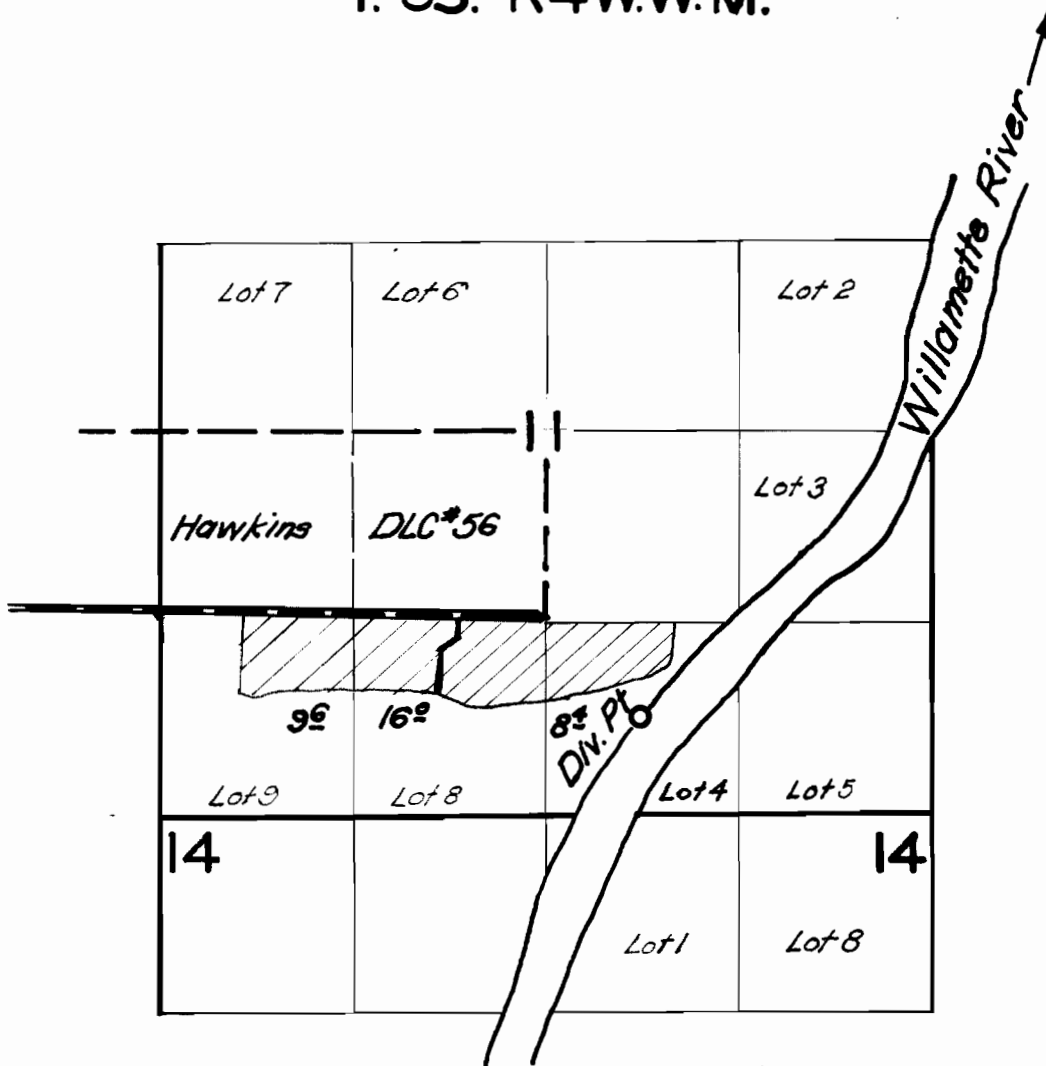

FINAL PROOF SURVEY
UNDER

Application No. 31484 Permit No. 24819
IN NAME OF

Emil Marx

Surveyed 21 June 1962, by Carl R. Baker