


# T.I.S.R.9 W.W.M.

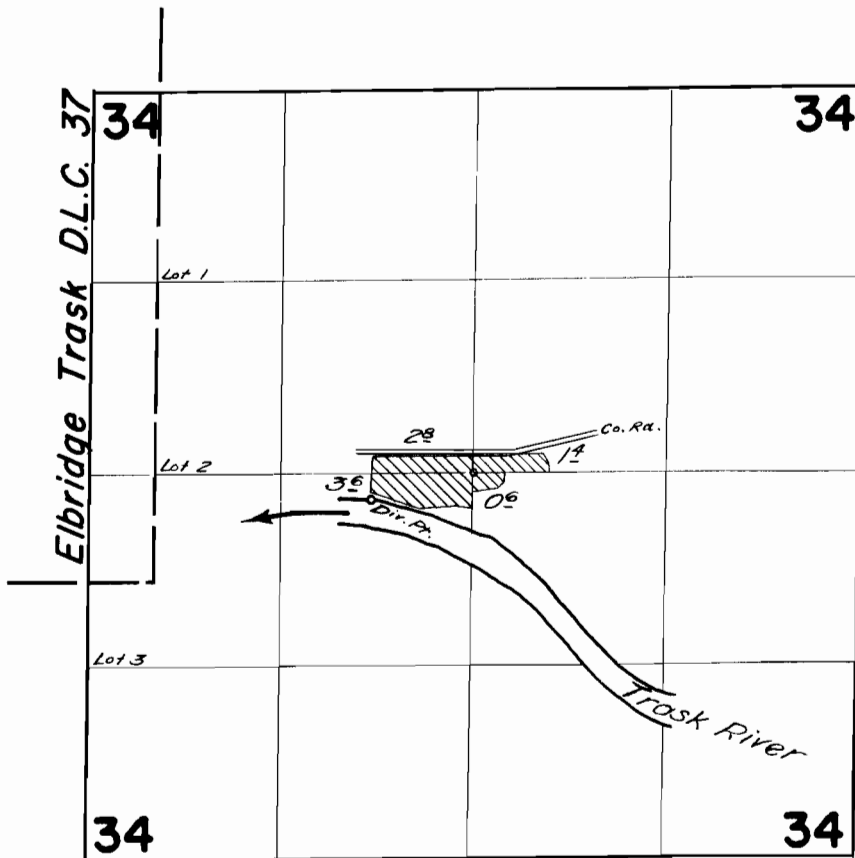

## FINAL PROOF SURVEY UNDER

Application No. 34241 Permit No. 26959  
IN NAME OF

DAVID H. KENNEDY

Surveyed July 24 1963, by *R. Jackson*