


T. 1 S. R. 9 W. W. M.

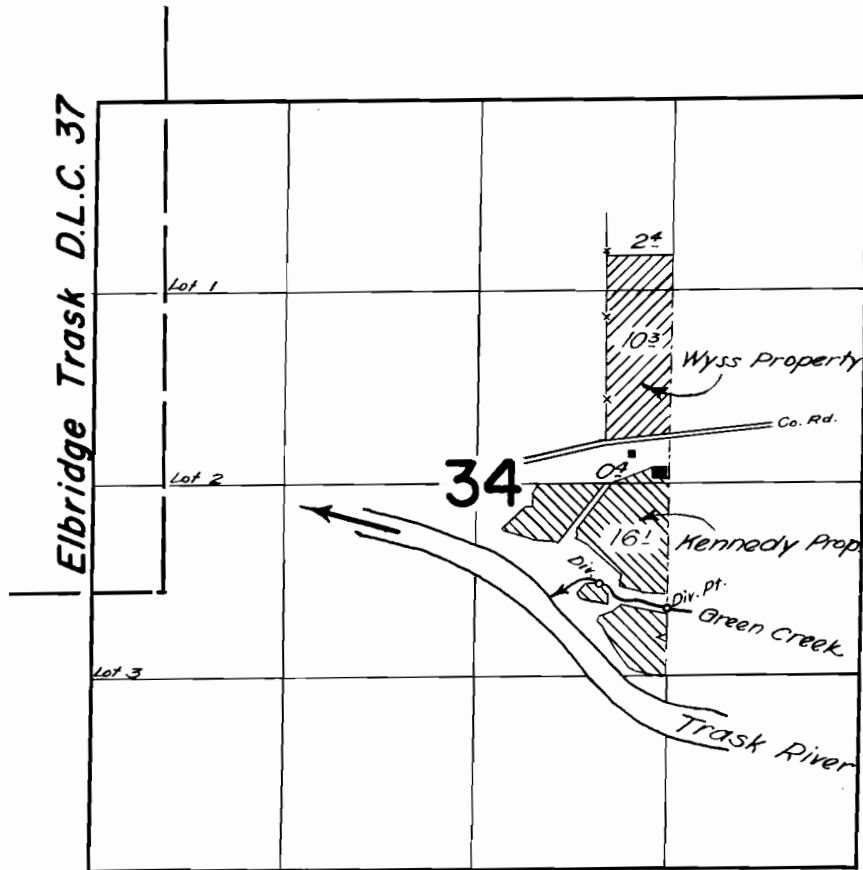

FINAL PROOF SURVEY UNDER

Application No. 37173..... Permit No. 28015.....
IN NAME OF

D. H. KENNEDY & HARVEY WYSS

Surveyed July 24 1963, by *R. Johnson*