




G-1158
G-1159
41942
31632
31714

T.6N.R.34&35E.W.M.

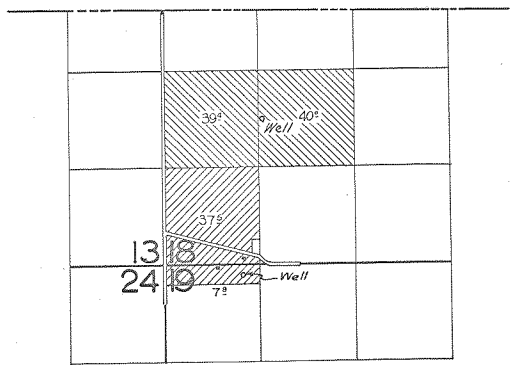

 G-1264
 G-1265

FINAL PROOF SURVEY UNDER

Application No. G-1264 Permit No. G-1158
G-1265 Permit No. G-1159
IN NAME OF

AL & PEARL BEARD

Surveyed May 1, 1962, by *R. Johnson*