


T.2 S. R. 39 E. W. M.

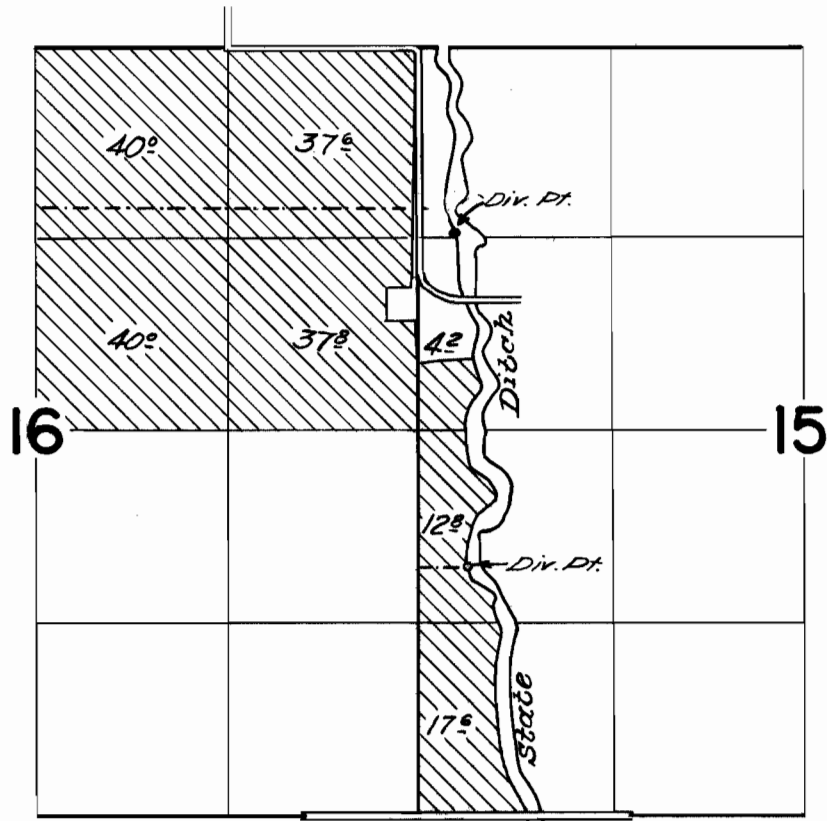

FINAL PROOF SURVEY UNDER

Application No. 37112..... Permit No. 27625...
IN NAME OF

CRESTON J. SHAW

Surveyed Oct. 3, 1963, by C. P. Baker.