


26598

# T. 1 N. R. 13 E. W.M.

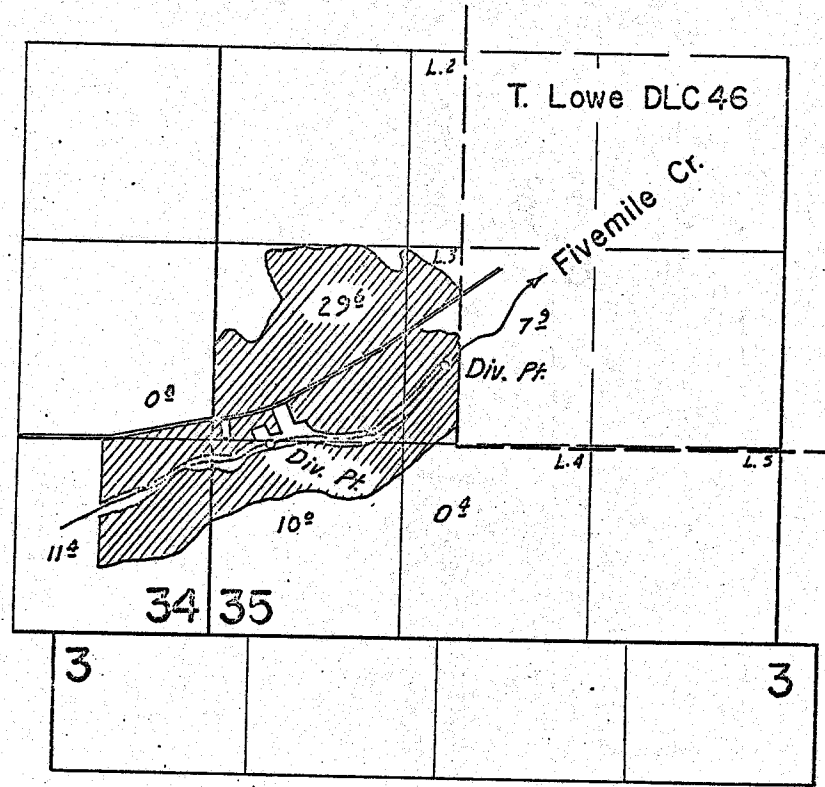

## FINAL PROOF SURVEY UNDER

Application No. 33666... Permit No. 26598  
 IN NAME OF  
**CLARENCE L. & SELMA K. GRAY**  
 Surveyed March 28 1963, by *L. W. J. J. J.*