


T. 1 N. R. 4 W.W.M.

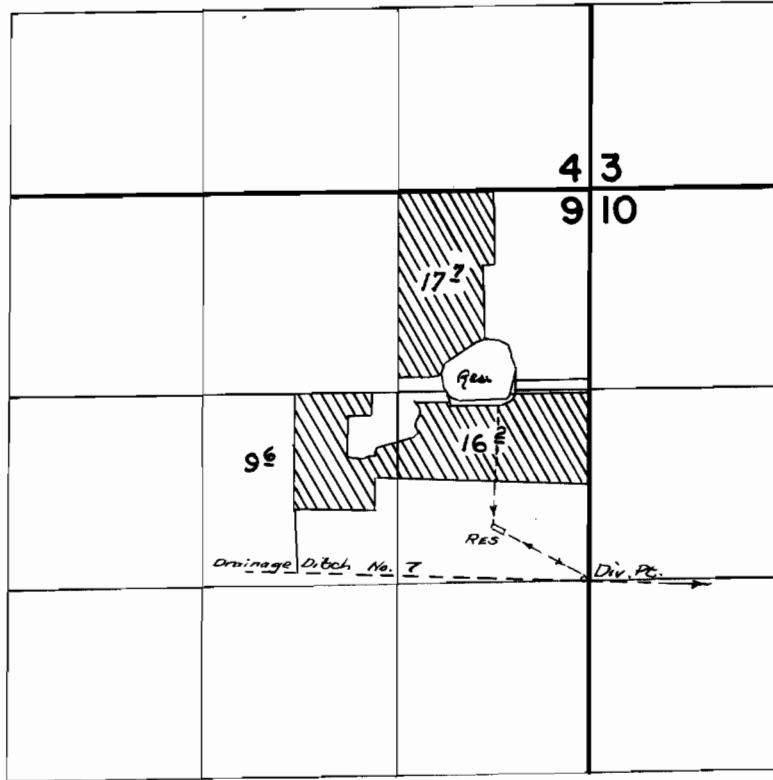

FINAL PROOF SURVEY UNDER

Application No. 32372 Permit No. 25563.
IN NAME OF

ALVIN H. & THERESA M. MEURY

Surveyed *May 31, 1962*, by *C.R. Baker*.....