


T. 1 N. R. 3 W. W. M.

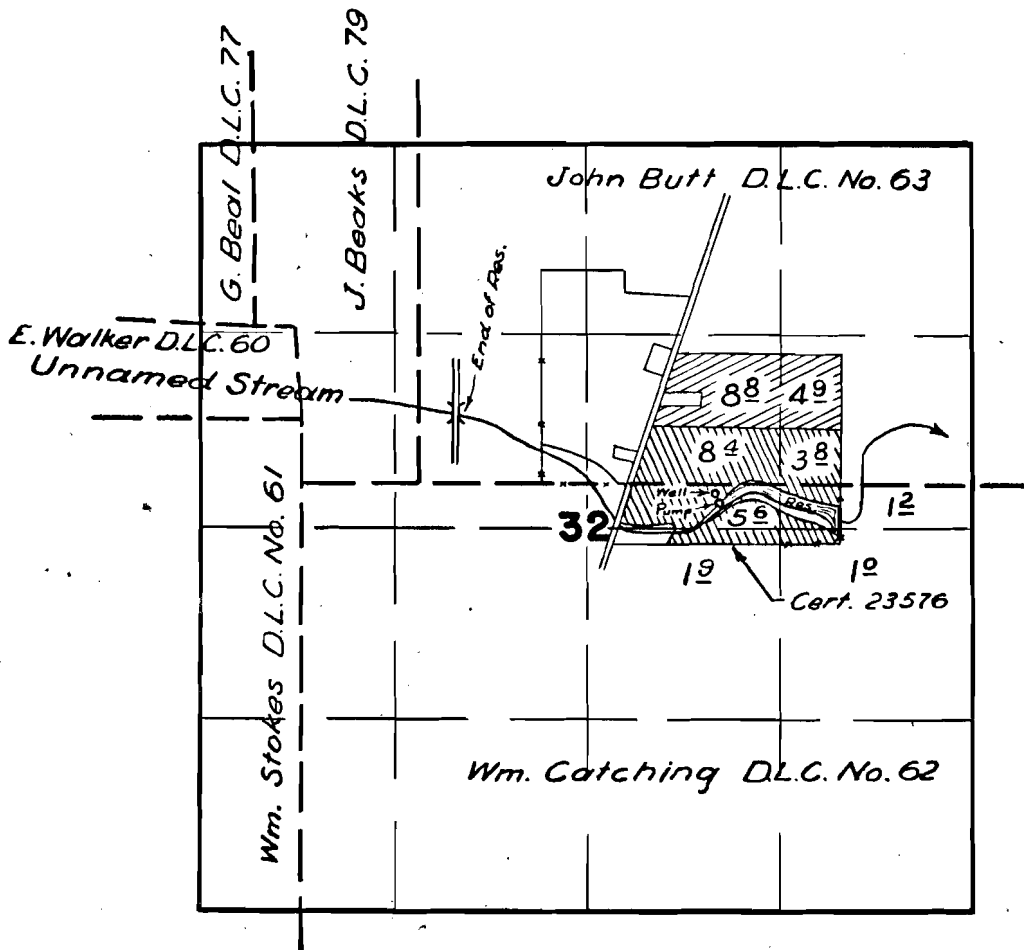

FINAL PROOF SURVEY UNDER

Application No. *R-33241* 33242 Permit No. *R-2285* 26402
 IN NAME OF

HERBERT B. SANNOU

Surveyed ^{May 27} ~~May 24~~ 1963, by *M. B. [Signature]*