


T. 3 S. R. 1 W. W. M.

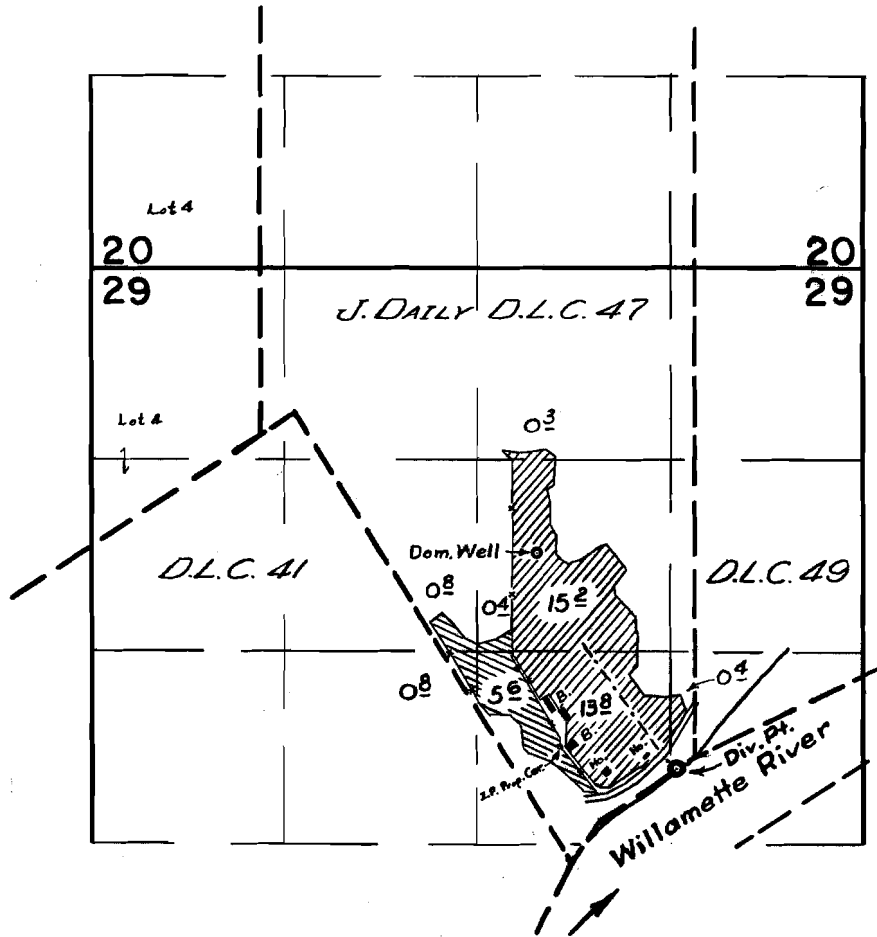

FINAL PROOF SURVEY UNDER

Application No. 31578 Permit No. 24965
IN NAME OF

JESS MCNIEL JR.

Surveyed April 2 1963, by m. Bish