


T.4S.R.1E.W.M.

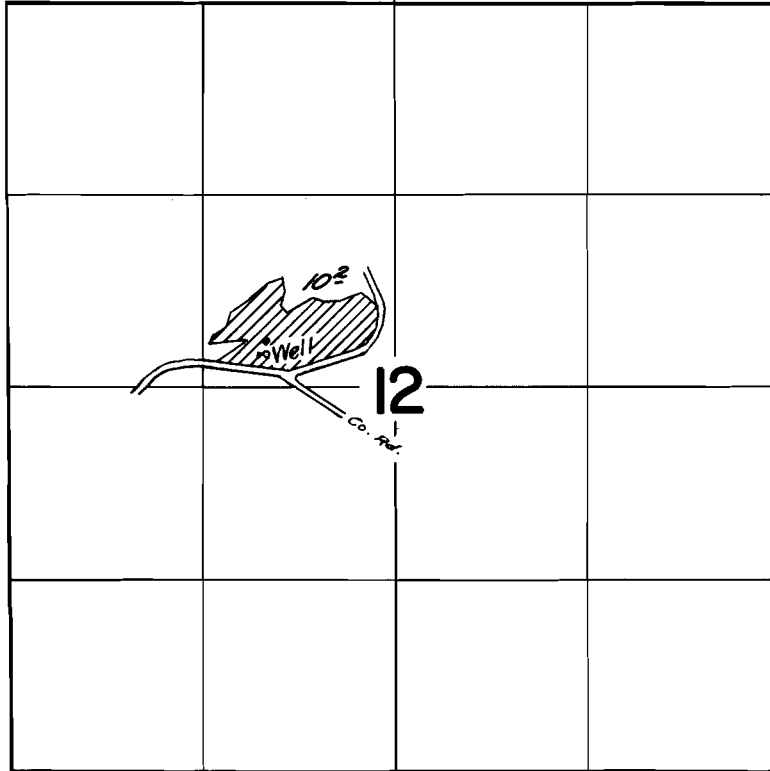

FINAL PROOF SURVEY
UNDER

Application No. G-2009... Permit No. G-1846...
IN NAME OF

.....LEONARD & HELEN BURDETT

Surveyed April 17, 1963, by *A. Jackson*