


T.6S.R.1E.W.M.

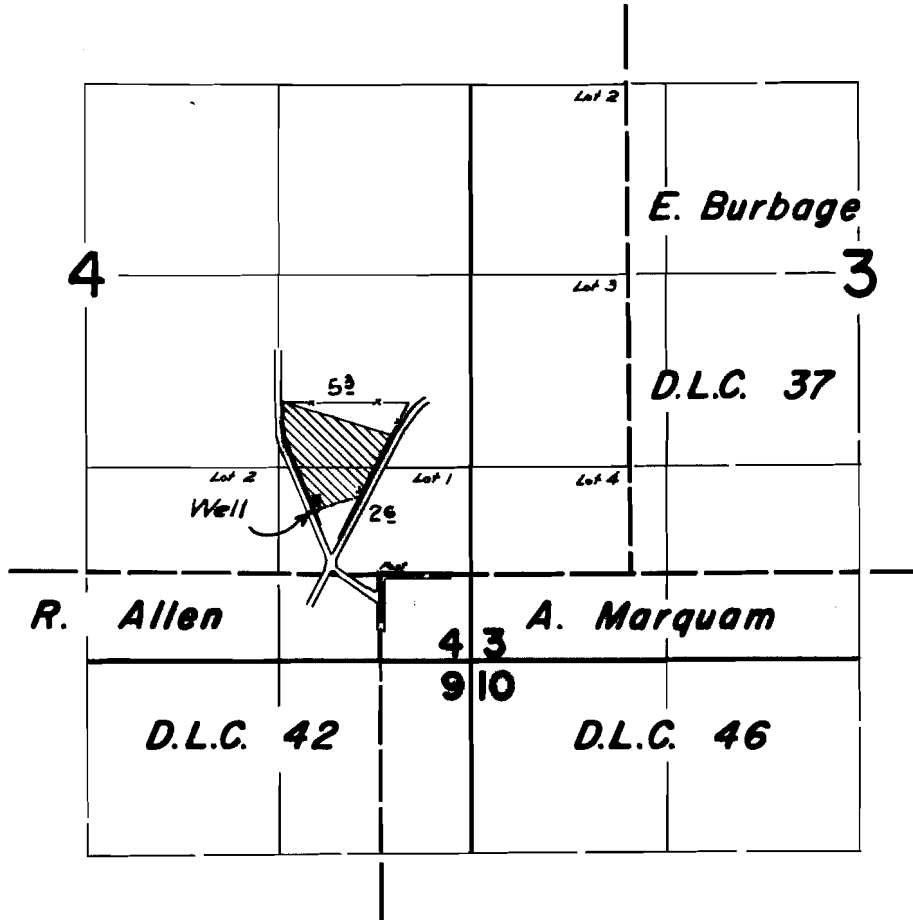

**FINAL PROOF SURVEY**  
UNDER

Application No. G-2069 Permit No. G-1906  
IN NAME OF

FLORENCE P. UHRIG

Surveyed April 2, 1963, by H. Peterson