


T.3&4S. R.2&3E.W.M.

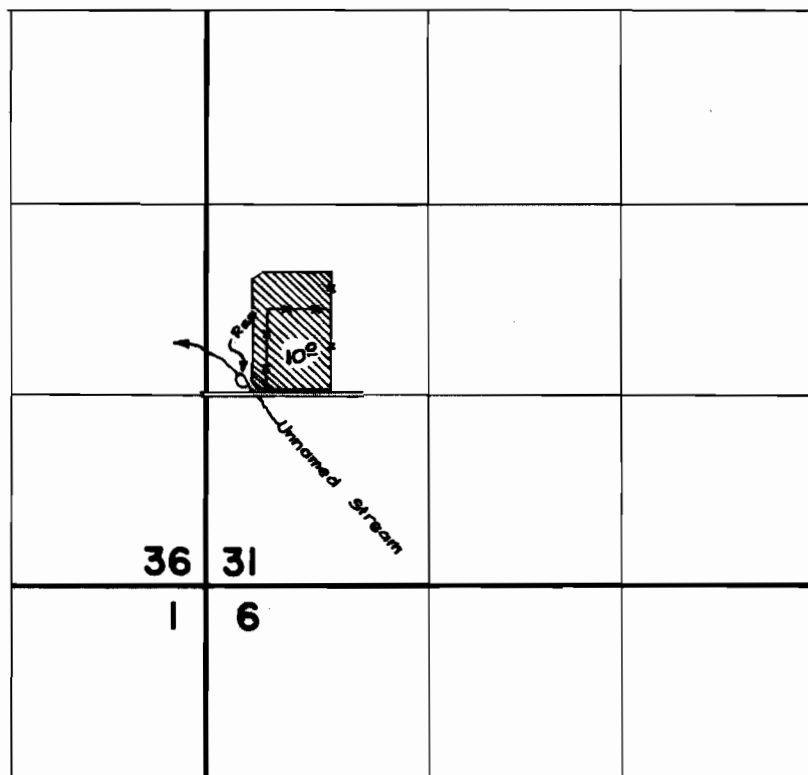

FINAL PROOF SURVEY
UNDER

Application No. R-26753 Permit No. R-1293
IN NAME OF

HAROLD & DAWNE WOOD

Surveyed June 2, 1961, by L.H. Jackson
APRIL 4 1963, by M. Bish