


T.3&4 S. R.2&3 E.W.M.

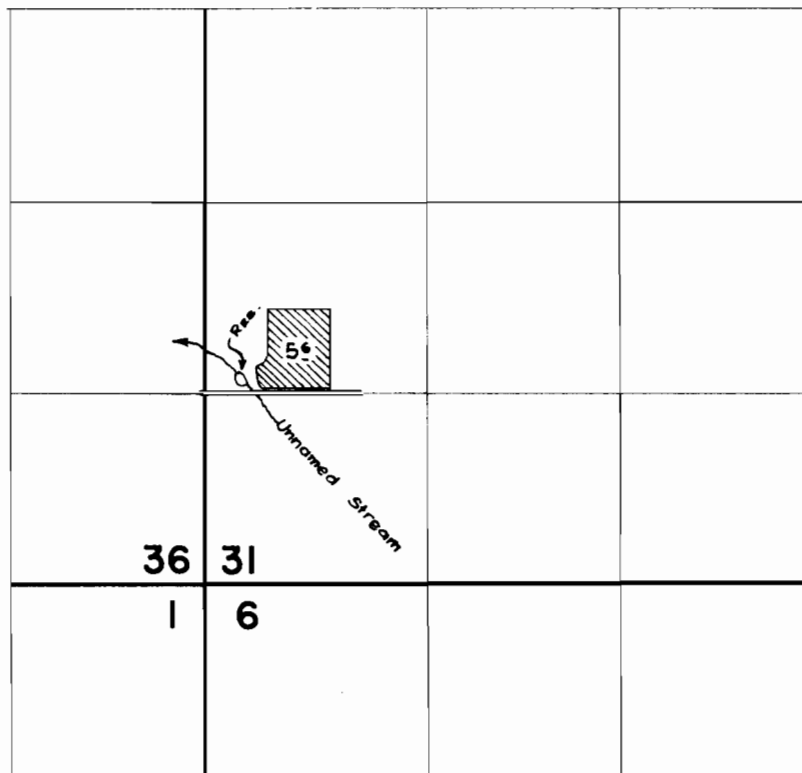

FINAL PROOF SURVEY
UNDER

Application No. **R-26753** **31871** Permit No. **R-1293** **25123**
IN NAME OF

HAROLD & DAWNE WOOD

Surveyed **June 2, 1961**, by *W. Jackson*