


T.2S.R.2E.W.M.

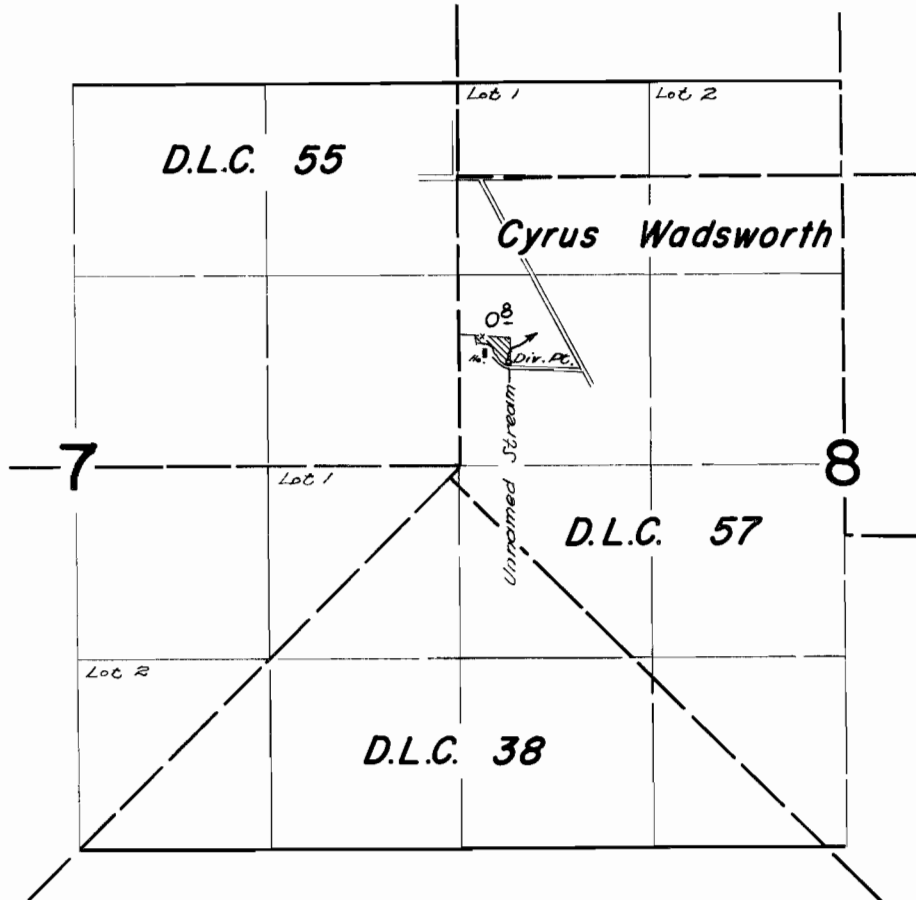

FINAL PROOF SURVEY UNDER

Application No. 31580... Permit No. 25228...
IN NAME OF

ROBERT FAIR WATSON

Surveyed April 25 1963, by *A. Jackson*