


# T.3S.R.3E.W.M.

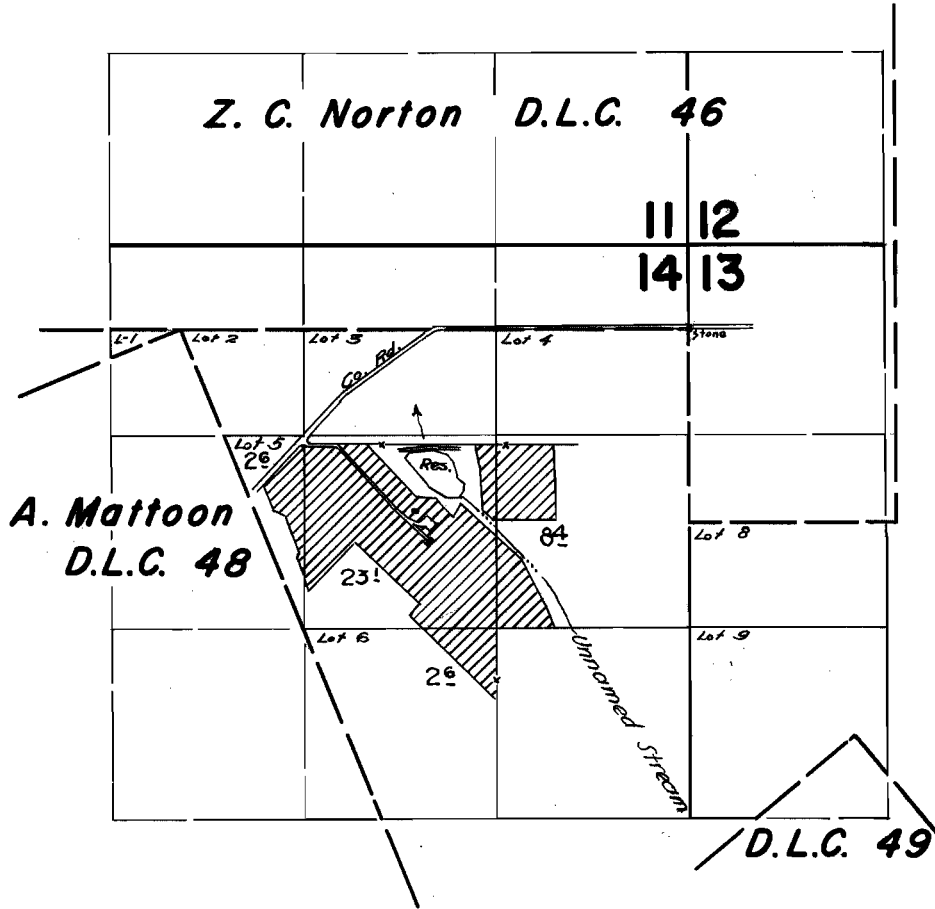

## FINAL PROOF SURVEY UNDER

**R-31641**                      **R-2098**  
Application No. **31642** Permit No. **25229**  
IN NAME OF

**DONALD R. SMITH**

Surveyed April 27 1961  
April 22 1963, by *[Signature]*