T.3S.R.3E.W.M.

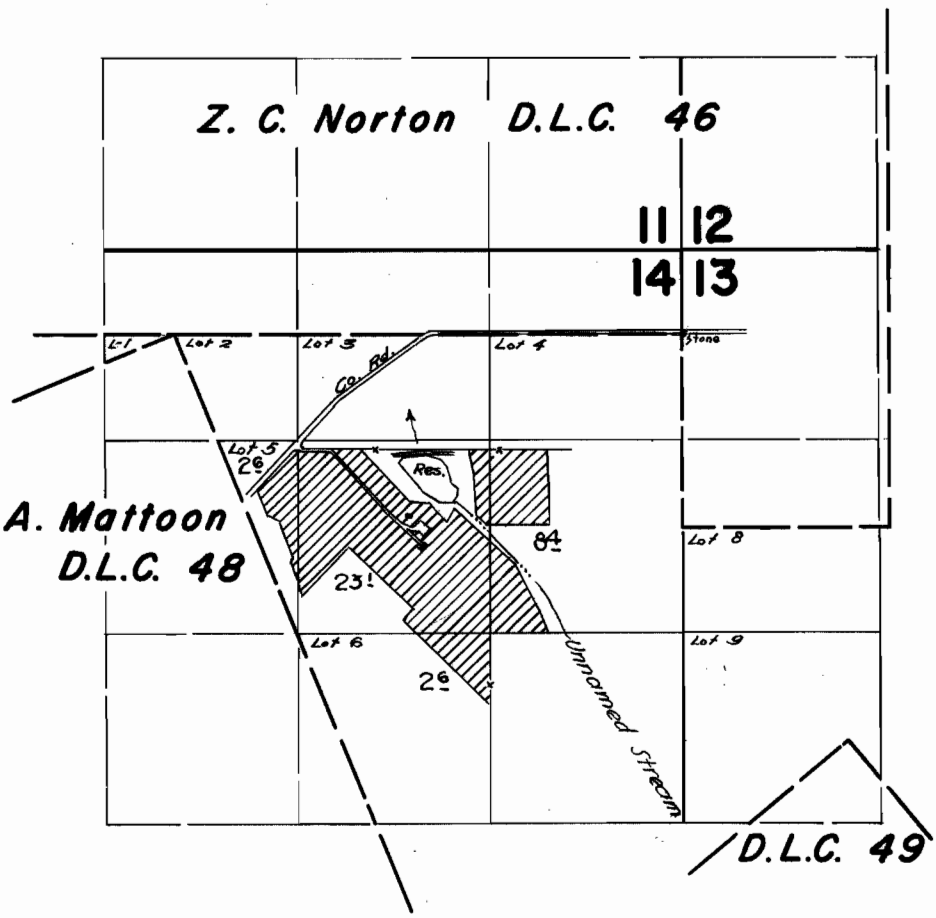

FINAL PROOF SURVEY
UNDER

R-31641 R-2098
Application No. 31642 Permit No. 25229
IN NAME OF

DONALD R. SMITH

Surveyed April 27 1961 / April 22 1963, by D. Jackson

1961-L & 1963-J