


T.4S.R.3E.W.M.

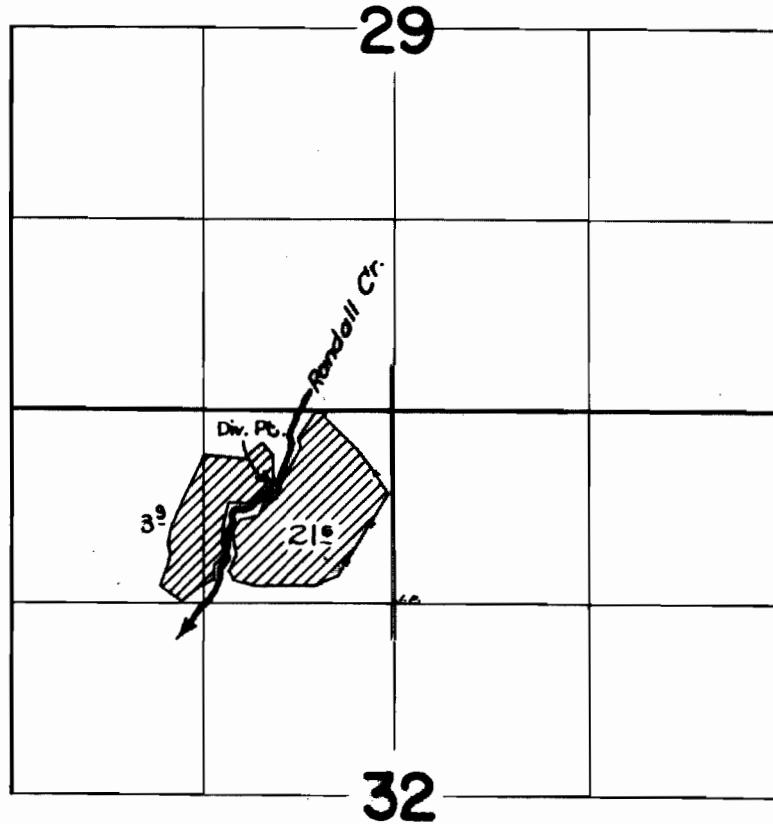

FINAL PROOF SURVEY
UNDER

Application No. 34785... Permit No. 27331...
IN NAME OF

JOSEPH W. KOOS

Surveyed April 23 1963., by

A handwritten signature in cursive script, appearing to read 'R. Jackson', is written over the text 'by' and extends to the right.