


T. 29S. R. 12W. W.M.

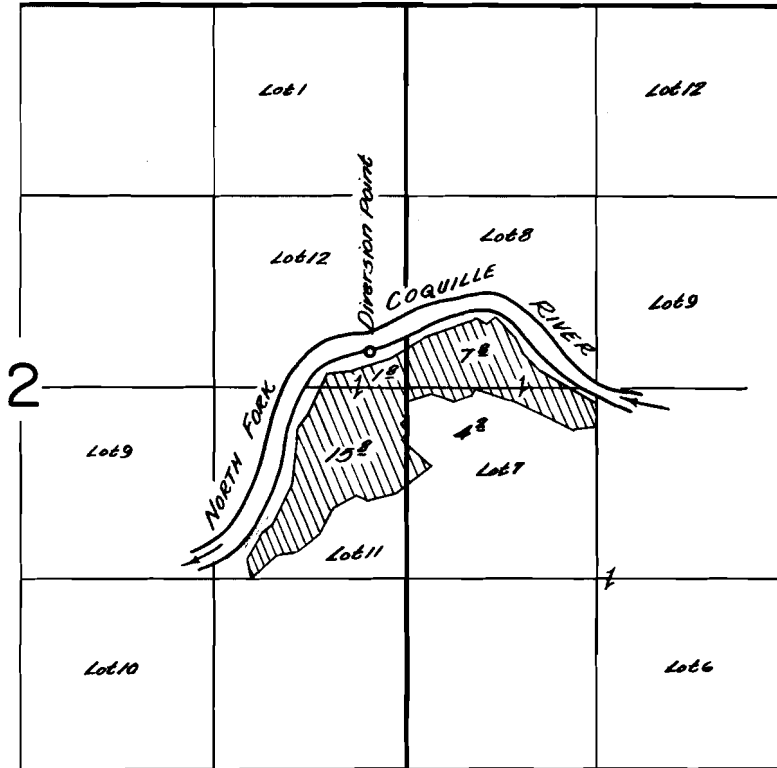

FINAL PROOF SURVEY
UNDER

Application No. 32408 Permit No. 25587
IN NAME OF

Fred A. Zumwalt

Surveyed Aug. 8 1963, by C. Baker