


T.13S.R.16E.W. M.

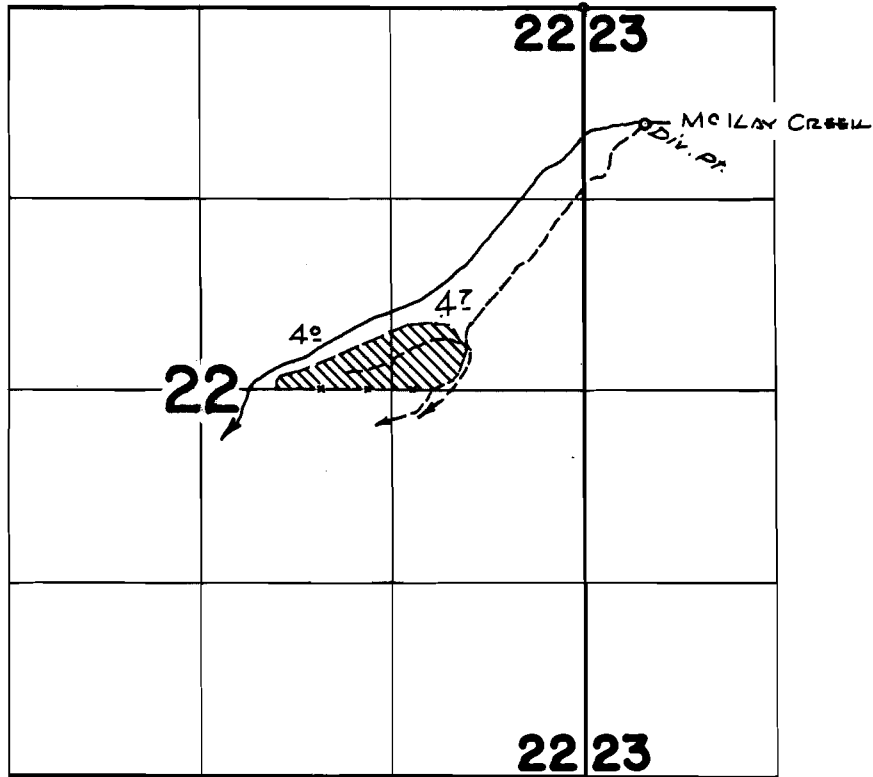

**FINAL PROOF SURVEY**  
UNDER

Application No. 32418 Permit No. 25594  
IN NAME OF

RUTH G. ELLIOTT

Surveyed July 18, 1963, by T. LAUER

*PL*