


T. 30 S. R. 6 W. W.M.

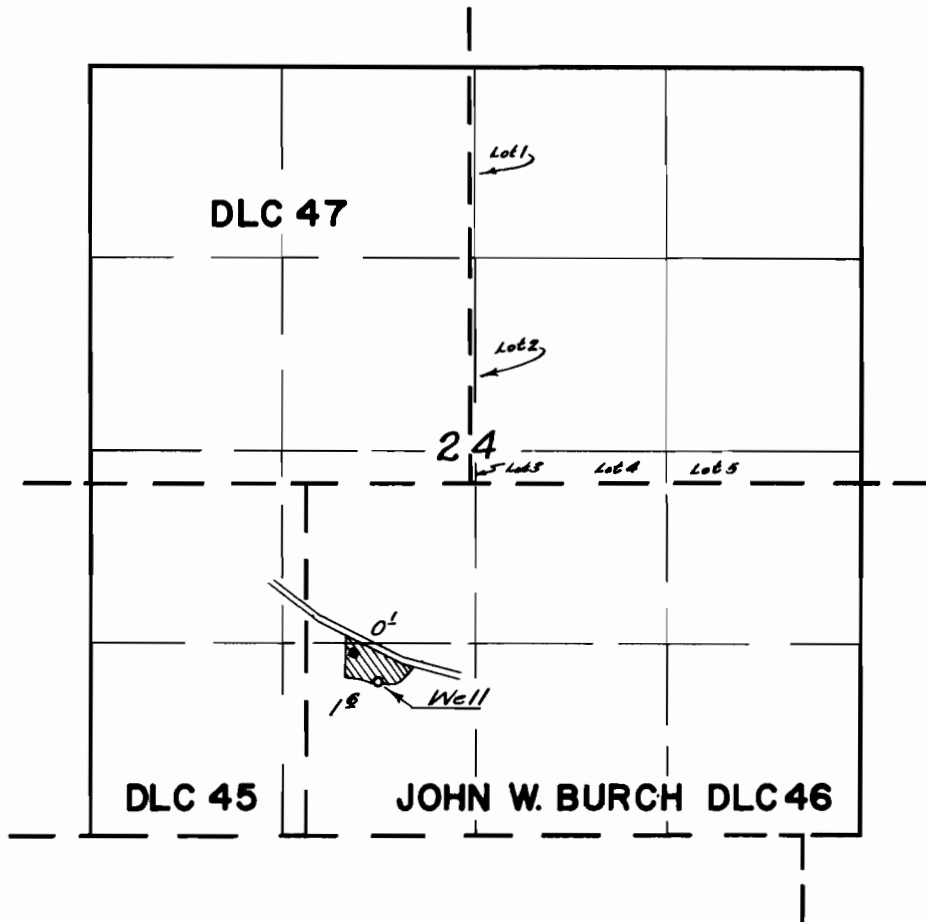

**FINAL PROOF SURVEY**  
UNDER

Application No. G-1062.. Permit No. G-1026...  
IN NAME OF

Guy R. and Henrietta W. Townsend

Surveyed April 4... 1963, by C. O. Bartels.....