


T21S.R.5W.W.M.

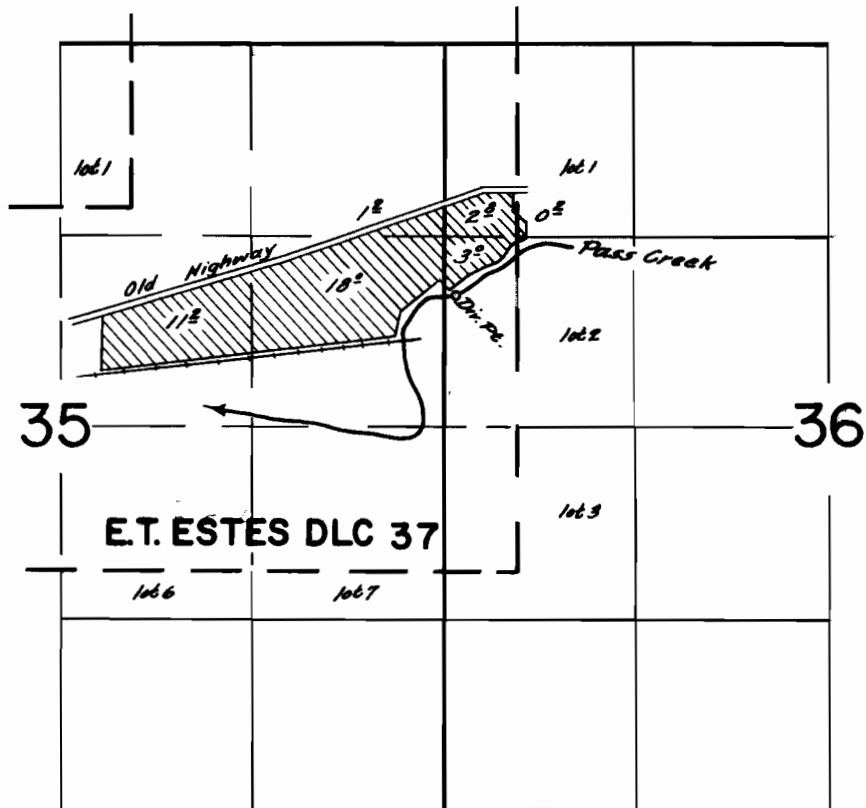

**FINAL PROOF SURVEY**  
UNDER

Application No. 33146 Permit No. 26209  
IN NAME OF

E.O. Breier

Surveyed March 26, 1963, by C.O. Bartels