


# T.24S.R.7W.W.M.

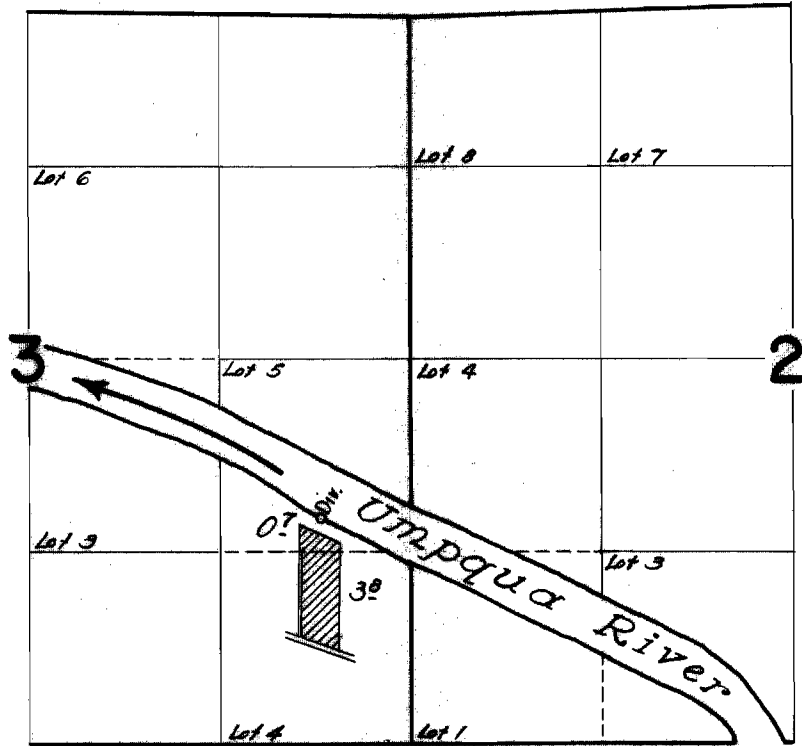

## FINAL PROOF SURVEY UNDER

Application No. 34397... Permit No. 27024...  
IN NAME OF

JOSEPH C. & ELEANOR STADLER

Surveyed June 12 1963, by T. Lauer