


T.21S.R.5W.W.M.

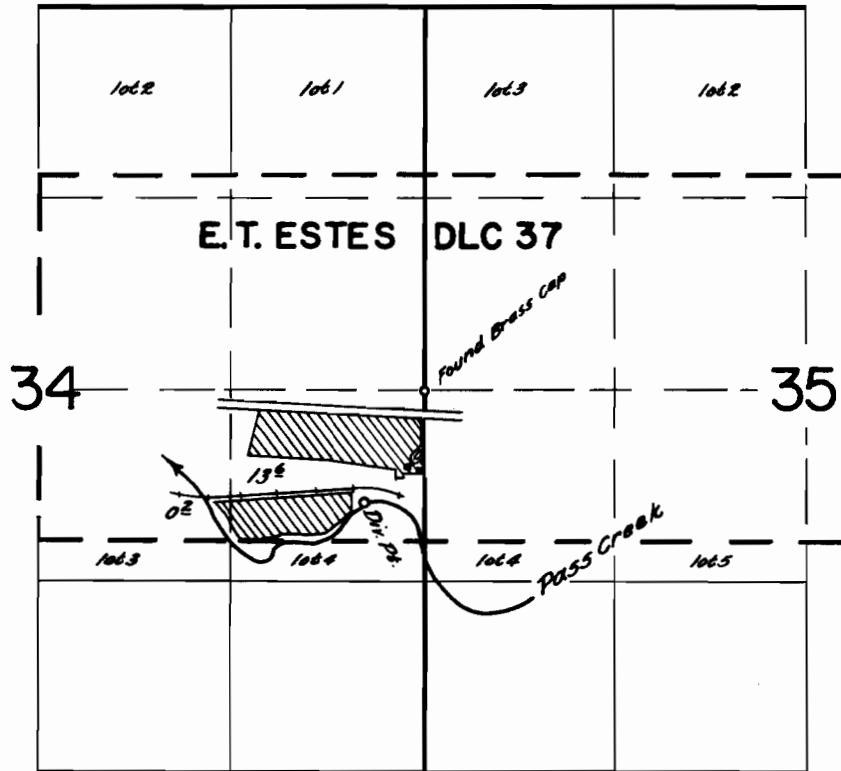

**FINAL PROOF SURVEY**  
UNDER

Application No. 34651 Permit No. 27219  
IN NAME OF

L. M. & Alice Hamacher

Surveyed Aug. 14, 1963, by C. O. Bartels