


T.26S.R.4W.W.M.

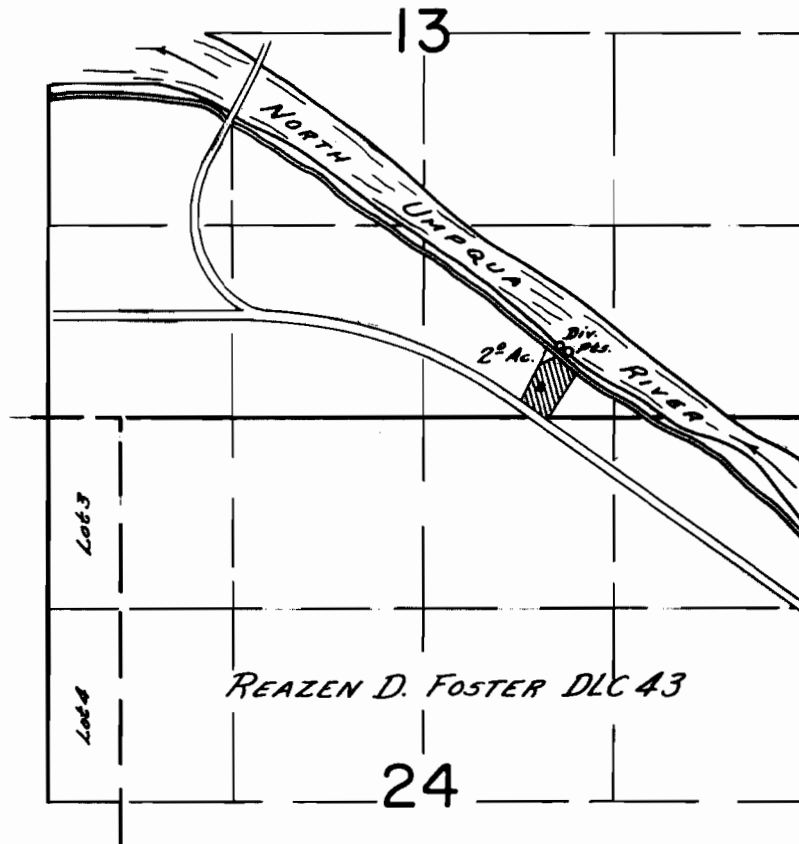

**FINAL PROOF SURVEY**  
UNDER

Application No. 34729 Permit No. 27269  
IN NAME OF

J. E. Rexroad

Surveyed April 1 1963, by C. O. Bartels