


T.20S.R.11W.W.M.

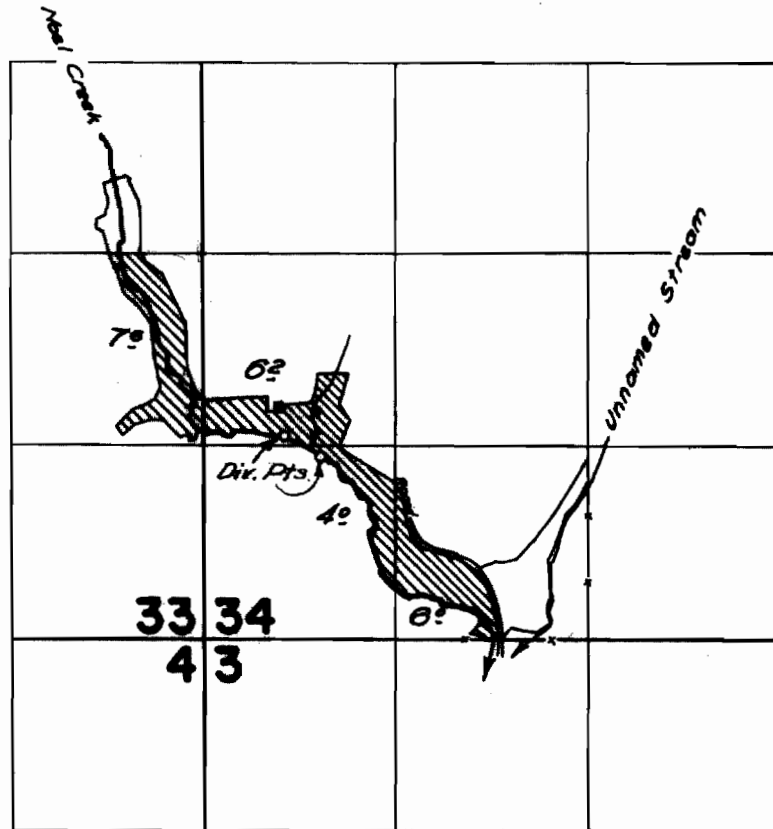

FINAL PROOF SURVEY UNDER

Application No. 34823... Permit No. 27394...
IN NAME OF

RAY & LOIS J. ROOKARD

Surveyed June 25, 1963, by *R. Jackson*