T.22 S. R.5 W.W.M.

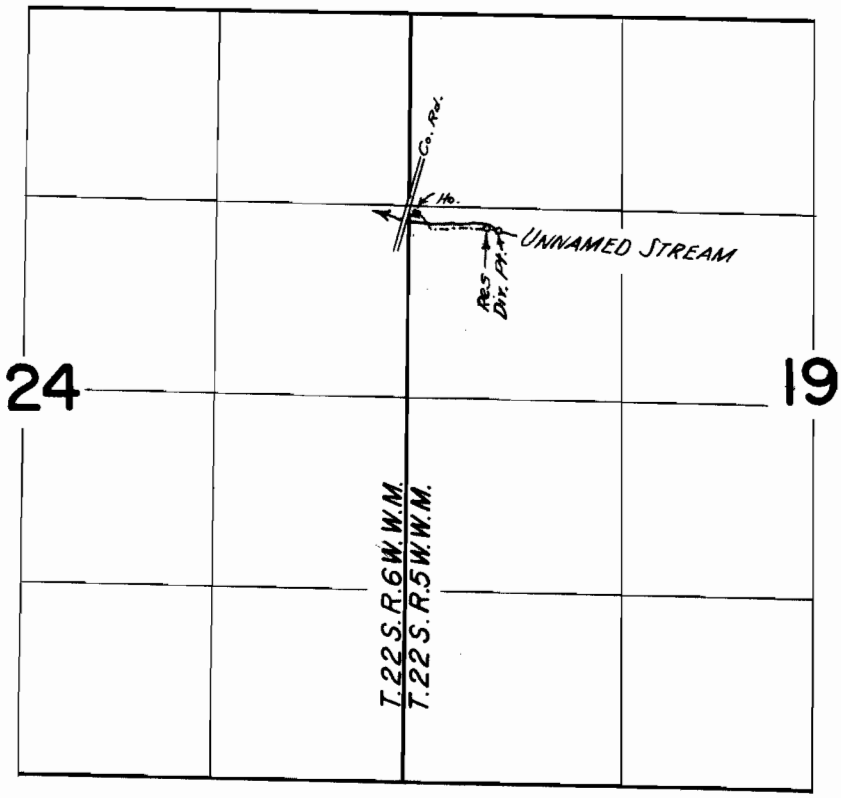

FINAL PROOF SURVEY
UNDER

Application No. 37783 Permit No. 28192
IN NAME OF

EVERETT E. BRYANT

Surveyed June 5 1963, by T. Lauer

1963-A