


P 26644 37663
31755

T. 9 S. R. 27 E. W. M.

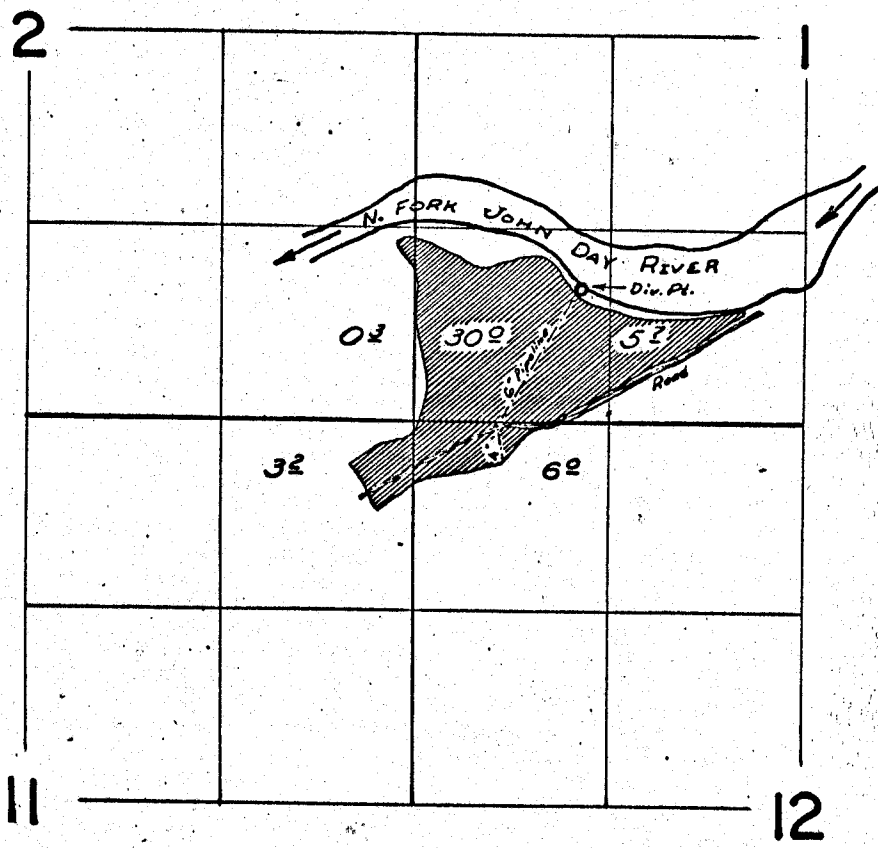

FINAL PROOF SURVEY UNDER

Application No. 33715 Permit No. 26644
IN NAME OF

VICTOR Du BOSCH

Surveyed JAN. 15 1964, by G. WARD
Relocated Sept. 13 1971, by H. DAGGETT

4-1964-A
4-1971-A